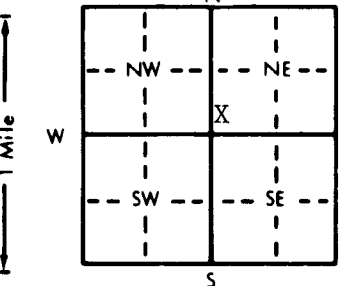


1 LOCATION OF WATER WELL:		Fraction	Section Number		Township Number	Range Number	
County: Haskell		SW 1/4 SW 1/4 NE 1/4	13		T 30 S	R 34 EW	
Distance and direction from nearest town or city street address of well if located within city? W. Highway 56	
2 WATER WELL OWNER: Satanta Cooperative Grain Co.	
RR#, St. Address, Box # : W. Hwy 56				Board of Agriculture, Division of Water Resources	
City, State, ZIP Code : Satanta, Kansas 67870				Application Number:	
3 LOCATE WELL'S LOCATION WITH AN "X" IN SECTION BOX:		4 DEPTH OF COMPLETED WELL ... 340.0 ... ft. ELEVATION: ...	
<div style="text-align: center;">N 1 Mile W E S</div> 		Depth(s) Groundwater Encountered 1. ft. 2. ft. 3. ft.	
		WELL'S STATIC WATER LEVEL ... 293.0 ... ft. below land surface measured on mo/day/yr	
		Pump test data: Well water was ft. after hours pumping gpm	
		Est. Yield gpm: Well water was ft. after hours pumping gpm	
		Bore Hole Diameter .875 in. to ft., and in. to ft.	
WELL WATER TO BE USED AS:	
5 Public water supply 8 Air conditioning 11 Injection well	
1 Domestic 3 Feedlot 6 Oil field water supply 9 Dewatering 12 Other (Specify below)	
2 Irrigation 4 Industrial 7 Lawn and garden only 10 Monitoring well MW-1	
Was a chemical/bacteriological sample submitted to Department? Yes.....No..X.....; If yes, mo/day/yr sample was submitted	
Water Well Disinfected? Yes No X	
5 TYPE OF BLANK CASING USED:	
1 Steel 3 RMP (SR) 5 Wrought iron 8 Concrete tile CASING JOINTS: Glued Clamped	
2 PVC 4 ABS 6 Asbestos-Cement 9 Other (specify below) Welded	
Blank casing diameter in. to 280 ft., Dia in. to ft., Dia in. to ft.	
Casing height above land surface 0.0 in., weight lbs./ft. Wall thickness or gauge No.	
TYPE OF SCREEN OR PERFORATION MATERIAL:	
1 Steel 3 Stainless steel 5 Fiberglass 8 RMP (SR) 10 Asbestos-cement	
2 Brass 4 Galvanized steel 6 Concrete tile 9 ABS 11 Other (specify)	
12 None used (open hole)	
SCREEN OR PERFORATION OPENINGS ARE:	
1 Continuous slot 3 Gauzed wrapped 8 Saw cut 11 None (open hole)	
2 Louvered shutter 4 Key punched 6 Wire wrapped 9 Drilled holes	
3 Mill slot 7 Torch cut 10 Other (specify)	
SCREEN-PERFORATED INTERVALS: From 330.0 ft. to 280.0 ft., From ft. to ft.	
From ft. to ft., From ft. to ft.	
GRAVEL PACK INTERVALS: From 330.0 ft. to 277.0 ft., From ft. to ft.	
From ft. to ft., From ft. to ft.	
6 GROUT MATERIAL: 1 Neat cement 2 Cement grout 3 Bentonite 4 Other	
Grout Intervals: From 277.0 ft. to 272.0 ft., From 272.0 ft. to 0.0 ft., From ft. to ft.	
What is the nearest source of possible contamination:	
1 Septic tank 4 Lateral lines 7 Pit privy 10 Livestock pens 14 Abandoned water well	
2 Sewer lines 5 Cess pool 8 Sewage lagoon 11 Fuel storage 15 Oil well/Gas well	
3 Watertight sewer lines 6 Seepage pit 9 Feedyard 12 Fertilizer storage 16 Other (specify below)	
13 Insecticide storage	
Direction from well? How many feet?	
<table border="1" style="width:100%; border-collapse: collapse;"><thead><tr><th>FROM</th><th>TO</th><th>LITHOLOGIC LOG</th><th>FROM</th><th>TO</th><th>PLUGGING INTERVALS</th></tr></thead><tbody><tr><td>0</td><td>5</td><td>Sandy loam, med brwn, moist, gravel, sm to lg, no odor</td><td></td><td></td><td></td></tr><tr><td>5</td><td>20</td><td>Clay, med to dk brwn, moist, caliche, buff, no odor</td><td></td><td></td><td></td></tr><tr><td>20</td><td>25</td><td>Sandy clay, med brwn, moist, clay, med brwn, some caliche, buff, no odor</td><td></td><td></td><td></td></tr><tr><td>25</td><td>35</td><td>sand, medbrn, some caliche buff, moist, no odor</td><td></td><td></td><td></td></tr><tr><td>35</td><td>45</td><td>Sand, light brn, fine grain, some clay, lt brn, moist, no odor</td><td></td><td></td><td></td></tr><tr><td>45</td><td>60</td><td>Sandy clay, lt brn, moist, no odor, sand, lt brn, some caliche, buff</td><td></td><td></td><td></td></tr><tr><td>60</td><td>70</td><td>Clayey sand, med brn, fine grain, moist, no odor</td><td></td><td></td><td></td></tr><tr><td>70</td><td>100</td><td>Sand, fine to largegrain, tan to rust, caliche, buff, moist, no odor</td><td></td><td></td><td></td></tr><tr><td>100</td><td>110</td><td>Sand, med to lg grain, tan to rust, clay, rust, lean, no odor</td><td></td><td></td><td></td></tr><tr><td>110</td><td>180</td><td>Sand, fine to lg grain, tan to rust, gravel, small to med, no odor</td><td></td><td></td><td></td></tr><tr><td>180</td><td>200</td><td>Sand, fn to lg grain, tan, gravel, small, clay, yellow to tan, no odor</td><td></td><td></td><td></td></tr><tr><td>200</td><td>210</td><td>Sandy clay, tan, sand, fine grain, tan, no odor</td><td></td><td></td><td></td></tr><tr><td>210</td><td>230</td><td>Sand, fn grain, tan, no odor</td><td></td><td></td><td></td></tr><tr><td>230</td><td>280</td><td>Sand, fine to lg grain, tan, some clay, tan, no odor</td><td></td><td></td><td></td></tr><tr><td>280</td><td>340</td><td>Sand lg grain, tan, gravel small to large, no odor</td><td></td><td></td><td></td></tr>
7 CONTRACTOR'S OR LANDOWNER'S CERTIFICATION: This water well was (1) constructed, (2) reconstructed, or (3) plugged under my jurisdiction and was completed on (mo/day/year) ... 2-21-94 ... and this record is true to the best of my knowledge and belief. Kansas Water Well Contractor's License No. ... 540 ... This Water Well Record was completed on (mo/day/yr) ... 3-23-94 ... under the business name of <u>Prairie Land Environmental Remediation, Inc.</u> (signature)	
INSTRUCTIONS: Use typewriter or ball point pen. PLEASE PRESS FIRMLY and PRINT clearly. Please fill in blanks, underline or circle the correct answers. Send top three copies to Kansas Department of Health and Environment, Bureau of Water, Topeka, Kansas 66620-0001. Telephone: 913-296-5545. Send one to WATER WELL OWNER and retain one for your records.	