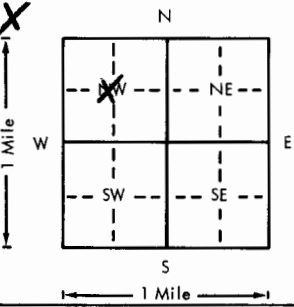


USE TYPEWRITER OR BALL
POINT PEN-PRESS FIRMLY,
PRINT CLEARLY.

WATER WELL RECORD
KSA 82a-1201-1215

Kansas Department of Health and
Environment-Division of Environment
(Water well Contractors)
Topeka, Kansas 66620

1. Location of well:		County Haskell County	Fraction <input checked="" type="checkbox"/> 1/4 C 1/4 NW 1/4	Section number 26	Township number T 30 S R 34	Range number EW
2. Distance and direction from nearest town or city: 1 1/2 South, 3/4 West, 1/4 South from West Side of Satanta			Owner of well: Charles Withers R.R. or street: Satanta KS 67870 City, state, zip code:			
4. Locate with "X" in section below:		Sketch map:		6. Bore hole dia. 26 in. Completion date 10-31-78 Well depth 400 ft.		
				7. <input type="checkbox"/> Cable tool <input type="checkbox"/> Rotary <input type="checkbox"/> Driven <input type="checkbox"/> Dug <input type="checkbox"/> Hollow rod <input type="checkbox"/> Jetted <input type="checkbox"/> Bored <input checked="" type="checkbox"/> Reverse rotary		
5. Type and color of material		From	To	8. Use: <input checked="" type="checkbox"/> Domestic <input type="checkbox"/> Public supply <input type="checkbox"/> Industry <input checked="" type="checkbox"/> Irrigation <input type="checkbox"/> Air conditioning <input type="checkbox"/> Stock <input type="checkbox"/> Lawn <input type="checkbox"/> Oil field water <input type="checkbox"/> Other		
				9. Casing: Material Steel Height: Above or below Threaded <input type="checkbox"/> Welded <input checked="" type="checkbox"/> Surface 1 ft. in. RMP <input type="checkbox"/> PVC <input type="checkbox"/> Weight 36.87 lbs./ft. Dia. 16 in. to 400 ft. depth Wall Thickness: inches or Dia. 16 in. to 400 ft. depth Gauge No. 219		
				10. Screen: Manufacturer's name Johnson Type Johnson Galv. Dia. 100 - 16" Slot/gauze 0-300 Plain Length 300-326 Perf. Set between 326-356 Screen 356-361 ft. Perf. 361-391 Screen and 391-400 Perf. ft. Gravel pack? yes Size range of material 1/4 to 5/8		
				11. Static water level: 197' ft. below land surface Date 9-21-78 mo./day/yr.		
				12. Pumping level below land surfaces: 207' ft. after 2 hrs. pumping 950 g.p.m. 213 ft. after 4 hrs. pumping 1325 g.p.m. Estimated maximum yield 1325 g.p.m.		
				13. Water sample submitted: Yes <input checked="" type="checkbox"/> No <input type="checkbox"/> Date		
				14. Well head completion: <input type="checkbox"/> Pitless adapter 1 ft. inches above grade		
				15. Well grouted? yes With: <input type="checkbox"/> Neat cement <input type="checkbox"/> Bentonite <input checked="" type="checkbox"/> Concrete Depth: From 0 ft. to 10 ft.		
				16. Nearest source of possible contamination: ft. N/A Direction N/A Type N/A Well disinfected upon completion? <input type="checkbox"/> Yes <input type="checkbox"/> No		
				17. Pump: Not installed Manufacturer's name Gould 6 stg. 12" Model number 150 HP 150 Volts 240 Length of drop pipe 280 ft. capacity 800 g.p.m. Type: <input type="checkbox"/> Submersible <input checked="" type="checkbox"/> Turbine <input type="checkbox"/> Jet <input type="checkbox"/> Reciprocating <input type="checkbox"/> Centrifugal <input type="checkbox"/> Other		
		(Use a second sheet if needed)				
18. Elevation:		19. Remarks:		20. Water well contractor's certification: This well was drilled under my jurisdiction and this report is true to the best of my knowledge and belief. Minter-Wilson Drilling Co. 208 Business name Box A, Garden City, KS 67846 License No. 1-19-77 Address Box A, Garden City, KS 67846 Signed [Signature] Date 1-19-77 Authorized representative		
Topography: <input type="checkbox"/> Hill <input type="checkbox"/> Slope <input type="checkbox"/> Upland <input type="checkbox"/> Valley						

Forward the white, blue and pink copies to the Department of Health and Environment

Form WWC-5

The
Professionals

MINTER-WILSON DRILLING CO.

INCORPORATED

Irrigation
and Domestic
Water Systems
Complete Installation
and Repairing

Phone 276-8269 • P.O. Box A • GARDEN CITY, KANSAS 67840

August 19, 1978

**Charles Withers
Haskell County**

**Location: N. W. $\frac{1}{4}$ 26-30-34 Satanta West side of town $1\frac{1}{2}$
mile South on black top $\frac{3}{4}$ West $\frac{1}{4}$ South 20 Feet
of pivot**

Static Water Level-260

Test #1

0	2	Top Soil
2	4	Brown Clay
4	6	Fine Sand
6	34	Brown Sandy Clay
34	47	Fine Sand
47	77	Brown Clay
77	136	Fine to med. sand and gravel (loose)
136	142	Brown Clay
142	187	Fine to med. sand and gravel
187	202	Brown Sandy Clay
202	214	Fine to med. sand and gravel 10% Clay
214	221	Gray Clay
221	229	Fine to med. sand and gravel
229	263	Brown Clay
263	278	Fine to med. sand and gravel 10% Clay
278	356	Fine to med. sand and gravel small streak of coarse gravel (loose)
356	361	Gray Clay
361	396	Fine to med. sand and gravel small streak of coarse gravel (loose)
396	410	Brown Clay white clay
410	418	Brown Sandy Clay mixed white rock hard
418	485	Brown Clay brown Rock mixed