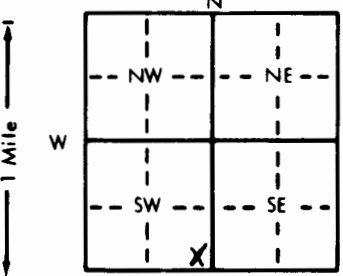


1 LOCATION OF WATER WELL: County: <u>Haskell</u>	Fraction <u>SE</u> $\frac{1}{4}$ <u>SE</u> $\frac{1}{4}$ <del>SW</del> $\frac{1}{4}$	Section Number <u>32</u>	Township Number <u>T</u> <u>30</u> <u>S</u>	Range Number <u>R</u> <u>34</u> <u>E</u> <u>W</u>
--	--	--------------------------	---	---

Distance and direction from nearest town or city street address of well if located within city? Satanta Approximately 4 1/2 mi. southwest on Hwy 56 - 1/2 mi west north into.

2 WATER WELL OWNER: <u>Jim Cullison</u>	Board of Agriculture, Division of Water Resources
RR#, St. Address, Box # : <u>Rt. 1</u>	Application Number:
City, State, ZIP Code : <u>Moscow, Kansas 67952</u>	

3 LOCATE WELL'S LOCATION WITH AN "X" IN SECTION BOX: 	4 DEPTH OF COMPLETED WELL: <u>108</u> ft. ELEVATION: Depth(s) Groundwater Encountered 1. <u>98</u> ft. 2. ft. 3. ft. WELL'S STATIC WATER LEVEL ft. below land surface measured on mo/day/yr <u>4-18-89</u> Pump test data: Well water was ft. after hours pumping gpm Est. Yield gpm: Well water was ft. after hours pumping gpm Bore Hole Diameter in. to ft. and in. to ft. WELL WATER TO BE USED AS: 5 Public water supply 8 Air conditioning 11 Injection well ① Domestic 3 Feedlot 6 Oil field water supply 9 Dewatering 12 Other (Specify below) 2 Irrigation 4 Industrial 7 Lawn and garden only 10 Monitoring well <u>Stockwell</u> Was a chemical/bacteriological sample submitted to Department? Yes No <u>X</u> ; If yes, mo/day/yr sample was submitted Water Well Disinfected? Yes No
--	---

5 TYPE OF BLANK CASING USED: 1 Steel 3 RMP (SR) ② PVC 4 ABS Blank casing diameter <u>Thin</u> in. to ft. Dia. in. to ft. Dia. in. to ft. Casing height above land surface <u>-48</u> in., weight lbs./ft. Wall thickness or gauge No. TYPE OF SCREEN OR PERFORATION MATERIAL: 1 Steel 3 Stainless steel 5 Fiberglass ⑦ PVC 10 Asbestos-cement 2 Brass 4 Galvanized steel 6 Concrete tile 9 ABS 11 Other (specify) 12 None used (open hole) SCREEN OR PERFORATION OPENINGS ARE: 1 Continuous slot 3 Mill slot 5 Gauzed wrapped 8 Saw cut 11 None (open hole) 2 Louvered shutter 4 Key punched 6 Wire wrapped 9 Drilled holes 7 Torch cut 10 Other (specify) SCREEN-PERFORATED INTERVALS: From ft. to ft., From ft. to ft., From ft. to ft. GRAVEL PACK INTERVALS: From ft. to ft., From ft. to ft., From ft. to ft.
---

6 GROUT MATERIAL: 1 Neat cement 2 Cement grout 3 Bentonite 4 Other	Grout Intervals: From <u>4</u> ft. to <u>10</u> ft., From <u>10</u> ft. to <u>30</u> ft., From <u>80</u> ft. to <u>98</u> ft.
What is the nearest source of possible contamination: ① Septic tank 4 Lateral lines 7 Pit privy 10 Livestock pens 14 Abandoned water well 2 Sewer lines 5 Cess pool 8 Sewage lagoon 11 Fuel storage 15 Oil well/Gas well 3 Watertight sewer lines 6 Seepage pit 9 Feedyard 12 Fertilizer storage 16 Other (specify below) 13 Insecticide storage	Direction from well? <u>Southwest</u> How many feet? <u>250</u>

FROM	TO	LITHOLOGIC LOG	FROM	TO	PLUGGING INTERVALS
0	4	Backfill & sand			
4	10	Neet cement			
10	30	Bentonite grout			
30	80	Chlorinated gravel			
80	98b	Bentonite grout			
98	108	Chlorinated gravel			
Glued cap on casing 4' below ground level, cemented over then backfilled					

7 CONTRACTOR'S OR LANDOWNER'S CERTIFICATION: This water well was (1) constructed, (2) reconstructed, or (3) plugged under my jurisdiction and was completed on (mo/day/year) <u>4-18-89</u> and this record is true to the best of my knowledge and belief. Kansas Water Well Contractor's License No. <u>118</u> . This Water Well Record was completed on (mo/day/yr) <u>5-5-89</u> under the business name of <u>Carlile Water Well Service, Inc.</u> by (signature) <u>[Signature]</u>
--