

## WATER WELL PLUGGING RECORD Form WWC-5P

KSA 82a-1212

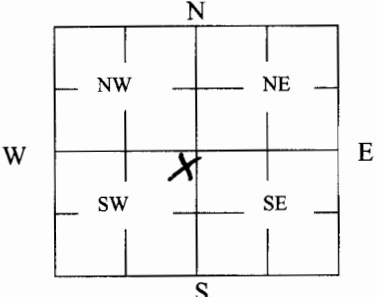
ID NO.

1 LOCATION OF WATER WELL: County: <u>Haskell</u>	Fraction <u>NE 1/4 NE 1/4 SW 1/4</u>	Section Number <u>31</u>	Township Number <u>30</u>	Range Number <u>34</u> E/W <u>W</u>
---	---	-----------------------------	------------------------------	--

Distance and direction from nearest town or city street address of well if located within city?

4 miles West & 2 miles South of Satanta

2 WATER WELL OWNER: <u>Cattle Empire</u> RR#, St. Address, Box #: <u>1174 Empire Circle</u> City, State ZIP Code: <u>Satanta, KS 66870</u>	Global Positioning Systems (decimal degrees, min. of 4 digits) Latitude: _____ Longitude: _____ Elevation: _____ Datum: _____ Data Collection Method: _____
--	--

3 MARK WELL'S LOCATION WITH AN "X" IN SECTION BOX: 	4 DEPTH OF WELL <u>140</u> ft. WELL'S STATIC WATER LEVEL <u>Dry</u> ft. WELL WAS USED AS: <table border="0"> <tr> <td><input checked="" type="radio"/> 1 Domestic</td> <td>5 Public Water Supply</td> <td>9 Dewatering</td> </tr> <tr> <td><input type="radio"/> 2 Irrigation</td> <td>6 Oil Field Water Supply</td> <td>10 Monitoring</td> </tr> <tr> <td><input type="radio"/> 3 Feedlot</td> <td>7 Domestic (Lawn &amp; Garden)</td> <td>11 Injection Well</td> </tr> <tr> <td><input type="radio"/> 4 Industrial</td> <td>8 Air Conditioning</td> <td>12 Other _____</td> </tr> </table> <p>Was a chemical/bacteriological sample submitted to Department? Yes _____ No <u>X</u></p>	<input checked="" type="radio"/> 1 Domestic	5 Public Water Supply	9 Dewatering	<input type="radio"/> 2 Irrigation	6 Oil Field Water Supply	10 Monitoring	<input type="radio"/> 3 Feedlot	7 Domestic (Lawn & Garden)	11 Injection Well	<input type="radio"/> 4 Industrial	8 Air Conditioning	12 Other _____
<input checked="" type="radio"/> 1 Domestic	5 Public Water Supply	9 Dewatering											
<input type="radio"/> 2 Irrigation	6 Oil Field Water Supply	10 Monitoring											
<input type="radio"/> 3 Feedlot	7 Domestic (Lawn & Garden)	11 Injection Well											
<input type="radio"/> 4 Industrial	8 Air Conditioning	12 Other _____											

5 TYPE OF BLANK CASING USED: <input checked="" type="radio"/> 1 Steel <input type="radio"/> 2 PVC <input type="radio"/> 3 RMP (SR) <input type="radio"/> 4 ABS <input type="radio"/> 5 Wrought <input type="radio"/> 6 Asbestos-Cement <input type="radio"/> 7 Fiberglass <input type="radio"/> 8 Concrete Tile <input type="radio"/> 9 Other (Specify below) _____	Blank casing diameter <u>5</u> in. Was casing pulled? Yes _____ No <u>X</u> If yes, how much _____ Casing height above or below land surface <u>100</u> in.
--	--

6 GROUT PLUG MATERIAL: 1 Neat cement 2 Cement grout <input checked="" type="radio"/> 3 Bentonite 4 Other _____	Grout Plug Intervals: From <u>5</u> ft. to <u>10</u> ft., From _____ ft. to _____ ft., From _____ to _____ ft.																				
What is the nearest source of possible contamination: <table border="0"> <tr> <td>1 Septic tank</td> <td>6 Seepage pit</td> <td>11 Fuel Storage</td> <td>16 Other (specify below) _____</td> </tr> <tr> <td>2 Sewer lines</td> <td>7 Pit privy</td> <td>12 Fertilizer storage</td> <td></td> </tr> <tr> <td>3 Watertight sewer lines</td> <td>8 Sewage lagoon</td> <td>13 Insecticide storage</td> <td></td> </tr> <tr> <td>4 Lateral lines</td> <td>9 Feedyard</td> <td><input checked="" type="radio"/> 14 Abandoned water well</td> <td>Direction from well? <u>East</u></td> </tr> <tr> <td>5 Cess pool</td> <td>10 Livestock pens</td> <td>15 Oil well/Gas well</td> <td>How many feet? <u>100</u></td> </tr> </table>		1 Septic tank	6 Seepage pit	11 Fuel Storage	16 Other (specify below) _____	2 Sewer lines	7 Pit privy	12 Fertilizer storage		3 Watertight sewer lines	8 Sewage lagoon	13 Insecticide storage		4 Lateral lines	9 Feedyard	<input checked="" type="radio"/> 14 Abandoned water well	Direction from well? <u>East</u>	5 Cess pool	10 Livestock pens	15 Oil well/Gas well	How many feet? <u>100</u>
1 Septic tank	6 Seepage pit	11 Fuel Storage	16 Other (specify below) _____																		
2 Sewer lines	7 Pit privy	12 Fertilizer storage																			
3 Watertight sewer lines	8 Sewage lagoon	13 Insecticide storage																			
4 Lateral lines	9 Feedyard	<input checked="" type="radio"/> 14 Abandoned water well	Direction from well? <u>East</u>																		
5 Cess pool	10 Livestock pens	15 Oil well/Gas well	How many feet? <u>100</u>																		

FROM	TO	PLUGGING MATERIALS	FROM	TO	PLUGGING MATERIALS
<u>140</u>	<u>10</u>	<u>Clay &amp; Subsoil</u>			
<u>10</u>	<u>5</u>	<u>Bentonite</u>			
<u>5</u>	<u>-</u>	<u>Cut off Casing &amp; Backfill</u>			

7 CONTRACTOR'S OR LANDOWNER'S CERTIFICATION: This water well was plugged under my jurisdiction and was completed on (mo/day/year) <u>6-22-15</u> and this record is true to the best of my knowledge and belief. Kansas Water Well Contractor's License No. <u>805</u> This Water Well Record was completed on (mo/day/year) <u>6-25-15</u> under the business name of <u>Southwest Windmill</u> by (signature) <u>David Egan</u>
---

**INSTRUCTIONS:** Use typewriter or ballpoint pen. Please press firmly and print clearly. Please fill in blanks, underline or circle the correct answers. Send top three copies to Kansas Department of Health and Environment, Bureau of Water, Geology Section, 1000 SW Jackson St., Ste. 420, Topeka, Kansas 66612-1367. Telephone: 785/296-5522. Send one to Water Well Owner and retain one for your records. Visit us at <http://www.kdheks.gov/geo/waterwells>.