

WATER WELL PLUGGING RECORD Form WWC-5P

KSA 82a-1212

ID NO.

1 LOCATION OF WATER WELL: County: <u>Haskell</u>	Fraction <u>¼ sw ¼ nw ¼ NE ¼</u>	Section Number <u>13</u>	Township Number <u>T 30 S</u>	Range Number <u>34</u> ☐ E ☒ W
--	-------------------------------------	-----------------------------	----------------------------------	--

Street/Rural Address of Well Location; if unknown, distance & direction from nearest town or intersection: If at owner's address, check here ☐ Hwy 56 at Ponca Ave
Satanta, KS


Global Positioning Systems (GPS) information:

Latitude: 37.4431566 (in decimal degrees)
Longitude: -100.9877383 (in decimal degrees)
Elevation: 2971.23
Horizontal Datum: ☐ WGS84, ☐ NAD83, ☒ NAD27
Collection Method:

2 WATER WELL OWNER: McDonald's 66/McDonald scot
RR#, St. Address, Box #:
City, State ZIP Code:

☐ GPS unit (Make/Model):
☐ Digital Map/Photo, ☐ Topographic Map, ☒ Land Survey
Est. Accuracy: ☐ < 3 m, ☐ 3-5 m, ☐ 5-15 m, ☐ > 15 m

3 MARK WELL'S LOCATION WITH AN "X" IN SECTION BOX:

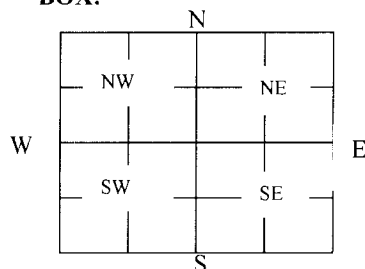

4 DEPTH OF WELL 390 ft.

WELL'S STATIC WATER LEVEL 355.23 ft

WELL WAS USED AS:

☐ Domestic	☐ Public Water Supply	☐ Dewatering
☐ Irrigation	☐ Oil Field Water Supply	☒ Monitoring
☐ Feedlot	☐ Domestic (Lawn & Garden)	☐ Injection Well
☐ Industrial	☐ Air Conditioning	☐ Other

Was a chemical/bacteriological sample submitted to Department? Yes ☐ No ☒

5 TYPE OF BLANK CASING USED:

☐ Steel ☐ RMP (SR) ☐ Wrought ☐ Fiberglass ☐ Other (Specify below)
☒ PVC ☐ ABS ☐ Asbestos-Cement ☐ Concrete Tile

Blank casing diameter 4 in. Was casing pulled? Yes ☒ No ☐ If yes, how much 3 feet
Casing height above or below land surface _____ in.

6 GROUT PLUG MATERIAL: ☐ Neat cement ☐ Cement grout ☒ Bentonite ☐ Other _____

Grout Plug Intervals: From 367 ft. to 3 ft., From _____ ft. to _____ ft., From _____ ft. to _____ ft.

What is the nearest source of possible contamination:

☐ Septic tank	☐ Seepage pit	☐ Fuel storage	☒ Other (specify below)
☐ Sewer lines	☐ Pit privy	☐ Fertilizer storage	<u>LUST</u>
☐ Watertight sewer lines	☐ Sewage lagoon	☐ Insecticide storage	
☐ Lateral lines	☐ Feedyard	☐ Abandoned water well	Direction from well? <u>southeast</u>
☐ Cess pool	☐ Livestock pens	☐ Oil well/Gas well	How many feet? <u>~400</u>

FROM	TO	PLUGGING MATERIALS	FROM	TO	PLUGGING MATERIALS
1	0	Concrete			
3	1	Native soil			
367	3	Bentonite Slurry			MW12
390	367	Silted In			

7 CONTRACTOR'S OR LANDOWNER'S CERTIFICATION: This water well was plugged under my jurisdiction and was completed on (mo/day/year) 8-23-2016 and this record is true to the best of my knowledge and belief. Kansas Water Well Contractor's License No. 594. This Water Well Record was completed on (mo/day/year) 8-31-2016 under the business name of Coranco Great Plains, Inc. by (signature) [Signature]

Send one white copy to Kansas Department of Health & Environment, Geology Section, 1000 SW Jackson Street, Ste. 420, Topeka, KS 66612-1367. Send one copy to WATER WELL OWNER and retain one for your records.

Visit us at <http://www.kdheks.gov/waterwell/index.html> Telephone 785-296-5524.

KSA82a-1212

Revised 1/20/2015