


1 LOCATION OF WATER WELL: Fraction NE 1/4 NE 1/4 SE 1/4 Section Number 11 Township Number T 30S S Range Number R 35W EW

Distance and direction from nearest town or city street address of well if located within city?
 2 1/2 MILES S. FROM RYOS, KS

2 WATER WELL OWNER: OXY USA, INC. #1 CLYMER A MLP
 RR#, St. Address, Box #: P.O. BOX 26100 Board of Agriculture, Division of Water Resources
 City, State, ZIP Code: OKLAHOMA CITY, OK 73126-0100 Application Number: 93-0255

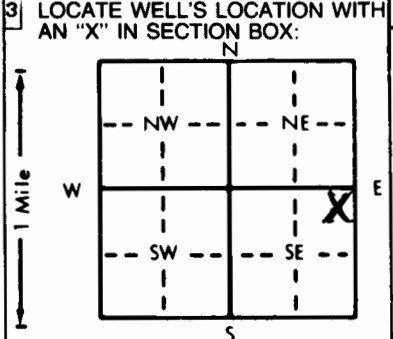

4 DEPTH OF COMPLETED WELL: 400 ft. ELEVATION: ...
 Depth(s) Groundwater Encountered 1. 225 ft. 2. ... ft. 3. ... ft.
 WELL'S STATIC WATER LEVEL ... 225 ft. below land surface measured on mo/day/yr 08-2-93
 Pump test data: Well water was 250 ft. after 1 hours pumping 100 gpm
 Est. Yield 100 gpm: Well water was ... ft. after ... hours pumping ... gpm
 Bore Hole Diameter ... 11 in. to 400 ft., and ... in. to ... ft.
 WELL WATER TO BE USED AS:
 1 Domestic 3 Feedlot 6 Oil field water supply 8 Air conditioning 11 Injection well
 2 Irrigation 4 Industrial 7 Lawn and garden only 9 Dewatering 12 Other (Specify below)
 Was a chemical/bacteriological sample submitted to Department? Yes X No; If yes, mo/day/yr sample was submitted
 Water Well Disinfected? Yes X No

5 TYPE OF BLANK CASING USED:
 1 Steel 3 RMP (SR) 5 Wrought iron 8 Concrete tile CASING JOINTS: Glued X Clamped
 2 PVC 4 ABS 6 Asbestos-Cement 9 Other (specify below) Welded
 7 Fiberglass Threaded
 Blank casing diameter 6 in. to 400 ft., Dia. ... in. to ... ft., Dia. ... in. to ... ft.
 Casing height above land surface 24 in., weight 2.902 lbs./ft. Wall thickness or gauge No. 280. SDR. 21
 TYPE OF SCREEN OR PERFORATION MATERIAL:
 1 Steel 3 Stainless steel 5 Fiberglass 8 RMP (SR) 10 Asbestos-cement
 2 Brass 4 Galvanized steel 6 Concrete tile 9 ABS 11 Other (specify)
 12 None used (open hole)
 SCREEN OR PERFORATION OPENINGS ARE:
 5 Gauzed wrapped 8 Saw cut 11 None (open hole)
 1 Continuous slot 3 Mill slot 6 Wire wrapped 9 Drilled holes
 2 Louvered shutter 4 Key punched 7 Torch cut 10 Other (specify)
 SCREEN-PERFORATED INTERVALS: From 300 ft. to 400 ft., From ... ft. to ... ft.
 GRAVEL PACK INTERVALS: From 280 ft. to 400 ft., From ... ft. to ... ft.

6 GROUT MATERIAL: 1 Neat cement 2 Cement grout 3 Bentonite 4 Other HOLE PLUG
 Grout Intervals: From 1 ft. to 20 ft., From ... ft. to ... ft., From ... ft. to ... ft.
 What is the nearest source of possible contamination:
 1 Septic tank 4 Lateral lines 7 Pit privy 10 Livestock pens 14 Abandoned water well
 2 Sewer lines 5 Cess pool 8 Sewage lagoon 11 Fuel storage 15 Oil well/Gas well
 3 Watertight sewer lines 6 Seepage pit 9 Feedyard 12 Fertilizer storage 16 Other (specify below)
 13 Insecticide storage
 Direction from well? NORTH How many feet? 146

FROM	TO	LITHOLOGIC LOG	FROM	TO	PLUGGING INTERVALS
0	3	BROWN CLAY	307	313	SAND W/ CLAY STREAKS
3	33	SANDY CLAY	313	336	SAND
33	52	CLAY	336	341	TAN CLAY
52	95	SAND	341	393	SAND
95	109	PEA GRAVEL	393	400	SANDY CLAY
109	157	SAND			
157	168	GRAVEL			
168	184	SAND			
184	213	CLAY			
213	232	SAND			
232	257	SANDY CLAY			
257	268	SMALL GRAVEL			
268	282	SAND			
282	293	BLUE CLAY			
293	307	SAND			

7 CONTRACTOR'S OR LANDOWNER'S CERTIFICATION: This water well was (1) constructed, (2) reconstructed, or (3) plugged under my jurisdiction and was completed on (mo/day/year) 08-2-93 and this record is true to the best of my knowledge and belief. Kansas Water Well Contractor's License No. KWWGL-430. This Water Well Record was completed on (mo/day/yr) 08-2-93 under the business name of HOWARD DRLG. CO. OK 73932 P.O. BOX 846 by (signature) Howard Drlg. Co.

INSTRUCTIONS: Use typewriter or ball point pen. PLEASE PRESS FIRMLY and PRINT clearly. Please fill in blanks, underline or circle the correct answers. Send top three copies to Kansas Department of Health and Environment, Bureau of Water, Topeka, Kansas 66620-0001. Telephone: 913-296-5545. Send one to WATER WELL OWNER and retain one for your records.

16709