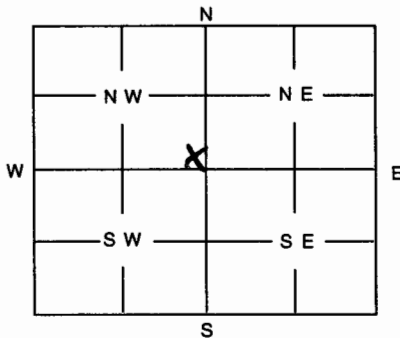


1	LOCATION OF WATER WELL: County: <u>Grant</u>	Fraction: <u>SE SE NW</u> <u>1/4 1/4 SE 1/4</u>	Section Number <u>13</u>	Township Number <u>30</u>	Range Number <u>35</u>
---	---	--	-----------------------------	------------------------------	---------------------------

Distance and direction from nearest town or city street address of well if located within city?

9 m SE 1/4 1/4 E of Olysses2 WATER WELL OWNER: Clint StalkerRR #, St. Address, Box #:
City, State, ZIP Code :Board of Agriculture, Division of Water Resources
Application Number:3 MARK WELL'S LOCATION WITH
AN "X" IN SECTION BOX:4 DEPTH OF WELL 300 ftWELL'S STATIC WATER LEVEL Dry ft.

WELL WAS USED AS:

☒ Domestic

2 Irrigation

3 Feedlot

4 Industrial

5 Public Water Supply

6 Oil Field Water Supply

7 Domestic (Lawn & Garden)

8 Air Conditioning

9 Dewatering

10 Monitoring Well

11 Injection Well

12 Other

Was a chemical / bacteriological sample submitted to Department? Yes No ☒

If yes, mo/day/yr sample was submitted

Water Well Disinfected: Yes ☒ No

5 TYPE OF BLANK CASING USED:

☒ Steel

3 RMP (SR)

5 Wrought

7 Fiberglass

9 Other (Specify below)

2 PVC

4 ABS

6 Asbestos-Cement

8 Concrete Tile

Blank casing diameter 7 in.Was casing pulled? Yes No ☒

If yes, how much

Casing height above or below land surface 36 in.6 GROUT PLUG MATERIAL: ☒ 1 Neat cement ☐ 2 Cement grout ☐ 3 Bentonite ☐ 4 Other

Grout Plug Intervals: From ft. to ft., From ft. to ft., From ft. to ft.

What is the nearest source of possible contamination:

1 Septic tank

2 Sewer lines

3 Watertight sewer lines

4 Lateral lines

5 Cess Pool

6 Seepage pit

7 Pit privy

8 Sewage lagoon

9 Feedyard

10 Livestock pens

11 Fuel storage

12 Fertilizer storage

13 Insecticide storage

14 Abandoned water well

☒ 15 Oil well/Gas well

16 Other (specify below)

Direction from well? EastHow many feet? 100

FROM	TO	PLUGGING MATERIALS
<u>300</u>	<u>6</u>	<u>Clay/Subsoil</u>
<u>6</u>	<u>3</u>	<u>Cement</u>
<u>3</u>	<u>-</u>	<u>Cut-off Casing & Bact. Kill</u>

RECEIVED

OCT 28 2004

BUREAU OF WATER

7 CONTRACTOR'S OR LANDOWNER'S CERTIFICATION: This water well was plugged under my jurisdiction and was completed on (mo/day/year) 9-29-04 and this record is true to the best of my knowledge and belief. Kansas Water Well Contractor's License No. 9-14-04 under the business name of Southwest Windmill This Water Well Record was completed on (mo/day/year)
by (signature) David Enns

INSTRUCTIONS: Use typewriter or ball point pen. Please press firmly and print clearly. Please fill in blanks, underline or circle the correct answers. Send top three copies to Kansas Department of Health and Environment, Bureau of Water, Topeka, Kansas 66620-0001. Telephone: 785/296-3565. Send one to Water Well Owner and retain one for your records.