


1 LOCATION OF WATER WELL: County: <u>Grant</u>	Fraction <u>SW 1/4 SW 1/4 NW 1/4</u>	Section Number <u>17</u>	Township Number <u>T 30 S</u>	Range Number <u>R 37 EW</u>
---	---	-----------------------------	----------------------------------	--------------------------------

Distance and direction from nearest town or city street address of well if located within city?  
From Ulysses - 9 Miles South, 2 Miles West, 1/2 Mile South and 150 Ft. East

2 WATER WELL OWNER: Don Carpenter  
 RR#, St. Address, Box # : RFD  
 City, State, ZIP Code : Ulysses, Kansas 67880  
 Board of Agriculture, Division of Water Resources  
 Application Number:

3 LOCATE WELL'S LOCATION WITH AN "X" IN SECTION BOX:

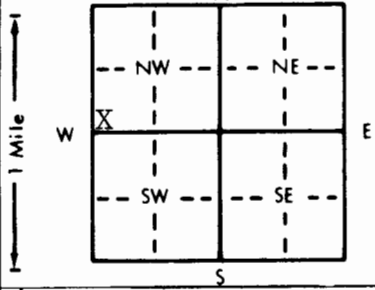

4 DEPTH OF COMPLETED WELL: 350 ft. ELEVATION: \_\_\_\_\_  
 Depth(s) Groundwater Encountered 1. \_\_\_\_\_ ft. 2. \_\_\_\_\_ ft. 3. \_\_\_\_\_ ft.  
 WELL'S STATIC WATER LEVEL 260 ft. below land surface measured on mo/day/yr 12-19-92  
 Pump test data: Well water was \_\_\_\_\_ ft. after \_\_\_\_\_ hours pumping \_\_\_\_\_ gpm  
 Est. Yield \_\_\_\_\_ gpm: Well water was \_\_\_\_\_ ft. after \_\_\_\_\_ hours pumping \_\_\_\_\_ gpm  
 Bore Hole Diameter: 12 1/2 in. to 350 ft., and \_\_\_\_\_ in. to \_\_\_\_\_ ft.  
 WELL WATER TO BE USED AS:  
 Domestic    3 Feedlot    6 Oil field water supply    9 Dewatering    12 Other (Specify below)  
 Irrigation    4 Industrial    7 Lawn and garden only    10 Monitoring well  
 Was a chemical/bacteriological sample submitted to Department? Yes \_\_\_\_\_ No ; If yes, mo/day/yr sample was submitted  
 Water Well Disinfected? Yes  No

5 TYPE OF BLANK CASING USED:  
 Steel    3 RMP (SR)    5 Wrought iron    8 Concrete tile    CASING JOINTS: Glued \_\_\_\_\_ Clamped \_\_\_\_\_  
 PVC    4 ABS    6 Asbestos-Cement    9 Other (specify below)    Welded   
 Fiberglass    from 324    Threaded \_\_\_\_\_  
 Blank casing diameter 6-5/8 in. to 304 ft., Dia. 6-5/8 in. to 330 ft., Dia. \_\_\_\_\_ in. to \_\_\_\_\_ ft.  
 Casing height above land surface 12 in., weight 17.02 lbs./ft. Wall thickness or gauge No. 250

TYPE OF SCREEN OR PERFORATION MATERIAL:  
 Steel    3 Stainless steel    5 Fiberglass    8 RMP (SR)    10 Asbestos-cement    11 Other (specify) \_\_\_\_\_  
 Brass    4 Galvanized steel    6 Concrete tile    9 ABS    12 None used (open hole)

SCREEN OR PERFORATION OPENINGS ARE:  
 Continuous slot    3 Mill slot    5 Gauzed wrapped    8 Saw cut    11 None (open hole)  
 Louvered shutter    4 Key punched    6 Wire wrapped    9 Drilled holes  
 Torch cut    10 Other (specify) \_\_\_\_\_

SCREEN-PERFORATED INTERVALS: From 304 ft. to 324 ft., From 330 ft. to 350 ft.  
 From \_\_\_\_\_ ft. to \_\_\_\_\_ ft., From \_\_\_\_\_ ft. to \_\_\_\_\_ ft.  
 GRAVEL PACK INTERVALS: From 260 ft. to 350 ft., From \_\_\_\_\_ ft. to \_\_\_\_\_ ft.  
 From \_\_\_\_\_ ft. to \_\_\_\_\_ ft., From \_\_\_\_\_ ft. to \_\_\_\_\_ ft.

6 GROUT MATERIAL: 1 Neat cement     Cement grout     Bentonite    4 Other \_\_\_\_\_  
 Grout Intervals: From 5 ft. to 25 ft., From 25 ft. to 260 ft., From \_\_\_\_\_ ft. to \_\_\_\_\_ ft.  
 What is the nearest source of possible contamination:  
 Septic tank    4 Lateral lines    7 Pit privy    10 Livestock pens    14 Abandoned water well  
 Sewer lines    5 Cess pool    8 Sewage lagoon    11 Fuel storage    15 Oil well/Gas well  
 Watertight sewer lines    6 Seepage pit    9 Feedyard    12 Fertilizer storage    16 Other (specify below) \_\_\_\_\_  
 13 Insecticide storage \_\_\_\_\_  
 Direction from well? \_\_\_\_\_ How many feet? \_\_\_\_\_

FROM	TO	LITHOLOGIC LOG	FROM	TO	PLUGGING INTERVALS
		See attached log			

7 CONTRACTOR'S OR LANDOWNER'S CERTIFICATION: This water well was  constructed, (2) reconstructed, or (3) plugged under my jurisdiction and was completed on (mo/day/year) 12-23-92 and this record is true to the best of my knowledge and belief. Kansas Water Well Contractor's License No. 208. This Water Well Record was completed on (mo/day/yr) 1-5-93 under the business name of Minter-Wilson Drilling Co., Inc. by (signature) Nora Keller

OFFICE USE ONLY