


1 LOCATION OF WATER WELL: Fraction SW 1/4 SW 1/4 SW 1/4 Section Number 31 Township Number T 30 S Range Number R 37 E/W  
 County: G1227

Distance and direction from nearest town or city street address of well if located within city?

13.5 3 W 2 S of Ulysses

2 WATER WELL OWNER: Tony Bassire  
 RR#, St. Address, Box # :  
 City, State, ZIP Code : Ulysses KS Board of Agriculture, Division of Water Resources Application Number:

3 LOCATE WELL'S LOCATION WITH: 4 DEPTH OF COMPLETED WELL 440 ft. ELEVATION:

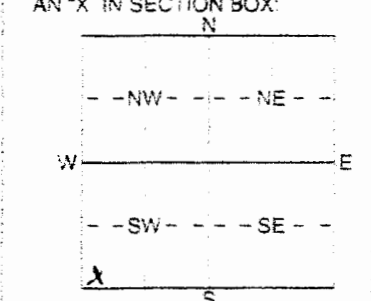

Depth(s) Groundwater Encountered 1 230 ft. 2 \_\_\_\_\_ ft. 3 \_\_\_\_\_ ft.  
 WELL'S STATIC WATER LEVEL 230 ft. below land surface measured on mo/day/yr 8-11-06  
 Pump test data: Well water was \_\_\_\_\_ ft. after \_\_\_\_\_ hours pumping \_\_\_\_\_ gpm  
 Est. Yield \_\_\_\_\_ gpm: Well water was \_\_\_\_\_ ft. after \_\_\_\_\_ hours pumping \_\_\_\_\_ gpm  
 WELL WATER TO BE USED AS:  
 Domestic  3 Feedlot  6 Oil field water supply  9 Dewatering  12 Other (Specify below)  
 2 Irrigation  4 Industrial  7 Domestic (lawn & garden)  10 Monitoring well

Was a chemical/bacteriological sample submitted to Department? Yes \_\_\_\_\_ No X If yes, mo/day/yr sample was submitted  
 Water Well Disinfected? Yes X No \_\_\_\_\_

5 TYPE OF BLANK CASING USED:  
 1 Steel  3 RMP (SR)  5 Wrought Iron  8 Concrete tile CASING JOINTS: Glued \_\_\_\_\_ Clamped \_\_\_\_\_  
 2 PVC  4 ABS  6 Asbestos-Cement  9 Other (specify below) Welded \_\_\_\_\_  
 7 Fiberglass \_\_\_\_\_ Threaded \_\_\_\_\_

Blank casing diameter 5 in. to 4.40 ft. Dia \_\_\_\_\_ in. to \_\_\_\_\_ ft. Dia \_\_\_\_\_ in. to \_\_\_\_\_ ft.  
 Casing height above land surface 2.4 in. weight \_\_\_\_\_ lbs./ft. Wall thickness or gauge No. SDR 21

TYPE OF SCREEN OR PERFORATION MATERIAL:  
 1 Steel  3 Stainless Steel  5 Fiberglass  PVC  10 Asbestos-Cement  
 2 Brass  4 Galvanized Steel  6 Concrete tile  8 RMP (SR)  11 Other (Specify) \_\_\_\_\_  
 9 ABS  12 None used (open hole)

SCREEN OR PERFORATION OPENINGS ARE:  
 1 Continuous slot  3 Mill slot  5 Gauzed wrapped  8 Saw cut  11 None (open hole)  
 2 Louvered shutter  4 Key punched  6 Wire wrapped  9 Drilled holes  
 7 Torch out  10 Other (specify) \_\_\_\_\_

SCREEN-PERFORATED INTERVALS: From 380 ft. to 440 ft. From \_\_\_\_\_ ft. to \_\_\_\_\_ ft.  
 From \_\_\_\_\_ ft. to \_\_\_\_\_ ft. From \_\_\_\_\_ ft. to \_\_\_\_\_ ft.  
 GRAVEL PACK INTERVALS: From 2.5 ft. to 4.40 ft. From \_\_\_\_\_ ft. to \_\_\_\_\_ ft.  
 From \_\_\_\_\_ ft. to \_\_\_\_\_ ft. From \_\_\_\_\_ ft. to \_\_\_\_\_ ft.

6 GROUT MATERIAL:  1 Neat cement  2 Cement grout  Bentonite  4 Other \_\_\_\_\_  
 Grout intervals: From 0 ft. to 25 ft. From \_\_\_\_\_ ft. to \_\_\_\_\_ ft. From \_\_\_\_\_ ft. to \_\_\_\_\_ ft.

What is the nearest source of possible contamination:  
 1 Septic tank  4 Lateral lines  7 Pit privy  10 Livestock pens  14 Abandoned water well  
 2 Sewer lines  5 Cess pool  8 Sewage lagoon  11 Fuel storage  15 Oil well/Gas well  
 3 Watertight sewer lines  6 Seepage pit  9 Feedyard  12 Fertilizer storage  16 Other (specify below)  
 13 Insecticide storage None observed

Direction from well? \_\_\_\_\_ How many feet? \_\_\_\_\_

FROM	TO	LITHOLOGIC LOG	FROM	TO	PLUGGING INTERVALS
0	20	Top soil + Brown clay			
20	60	Caliche, clay + sand s/ks.			
60	120	med Sand + sandy clay			
120	180	Sandy clay			
180	200	Sand + Gravel			
200	226	Brown clay			
226	340	S med to coarse			
340	440	Cemented Sand			
450		Red Bed			

7 CONTRACTOR'S OR LANDOWNER'S CERTIFICATION: This water well was (1) constructed (2) reconstructed, or (3) plugged under my jurisdiction and was completed on (mo/day/year) 8-11-06 and this record is true to the best of my knowledge and belief. Kansas Water Well Contractor's Licence No 473 This Water Well Record was completed on (mo/day/yr) 8-12-06 under the business name of Tyler Water Well Inc by (signature) Daryl S. H.