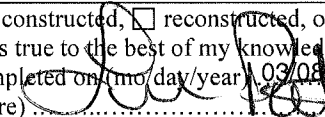


## WATER WELL RECORD

## Form WWC-5

Division of Water Resources App. No. 

<b>1 LOCATION OF WATER WELL:</b> County: Grant		Fraction NW ¼ NW ¼ ¼ ¼		Section Number 10	Township No. T 30 S	Range Number R 37 <input type="checkbox"/> E <input checked="" type="checkbox"/> W															
Street/Rural Address of Well Location; if unknown, distance & direction from nearest town or intersection: If at owner's address, check here <input type="checkbox"/> . 215 East Road 20 Ulysses, Kansas				<b>Global Positioning System (GPS) information:</b> Latitude: N37.458795 (in decimal degrees) Longitude: W101.358232 (in decimal degrees) Elevation: ..... Datum: <input type="checkbox"/> WGS 84, <input type="checkbox"/> NAD 83, <input type="checkbox"/> NAD 27 Collection Method: <input checked="" type="checkbox"/> GPS unit (Make/Model: Handy GPS) <input type="checkbox"/> Digital Map/Photo, <input type="checkbox"/> Topographic Map, <input type="checkbox"/> Land Survey Est. Accuracy: <input type="checkbox"/> <3 m, <input type="checkbox"/> 3-5 m, <input checked="" type="checkbox"/> 5-15 m, <input type="checkbox"/> >15 m																	
<b>2 WATER WELL OWNER:</b> Pioneer Natural Resources, USA RR#, Street Address, Box #: P.O. Box 2788 City, State, ZIP Code : Amarillo, Texas 79105																					
<b>3 LOCATE WELL WITH AN "X" IN SECTION BOX:</b> N <table border="1" style="margin: 10px auto; width: 100px; text-align: center;"> <tr><td></td><td></td><td></td></tr> <tr><td>-- NW --</td><td></td><td>-- NE --</td></tr> <tr><td></td><td></td><td></td></tr> <tr><td>-- SW --</td><td></td><td>-- SE --</td></tr> <tr><td></td><td></td><td></td></tr> </table> W <div style="text-align: center;">S  -----1 mile----- </div>					-- NW --		-- NE --				-- SW --		-- SE --				<b>4 DEPTH OF COMPLETED WELL</b> 110 ft. <span style="float: right;">SVE-3</span> Depth(s) Groundwater Encountered (1)..... ft. (2)..... ft. (3)..... ft. WELL'S STATIC WATER LEVEL.....ft. below land surface measured on mo/day/yr..... Pump test data: Well water was.....ft. after..... hours pumping..... gpm EST. YIELD.....gpm. Well water was.....ft. after..... hours pumping..... gpm Bore Hole Diameter 8 3/4 in. to 112 ft., and .....in. to .....ft. WELL WATER TO BE USED AS: <input type="checkbox"/> Public water supply <input type="checkbox"/> Geothermal <input type="checkbox"/> Injection well <input type="checkbox"/> Domestic <input type="checkbox"/> Feedlot <input type="checkbox"/> Oil field water supply <input type="checkbox"/> Dewatering <input checked="" type="checkbox"/> Other (Specify below) <input type="checkbox"/> Irrigation <input type="checkbox"/> Industrial <input type="checkbox"/> Domestic-lawn & garden <input type="checkbox"/> Monitoring well <input type="checkbox"/> Soil Vapor Extr. Was a chemical/bacteriological sample submitted to Department? <input type="checkbox"/> Yes <input checked="" type="checkbox"/> No If yes, mo/day/yr sample was submitted..... Water well disinfected? <input type="checkbox"/> Yes <input checked="" type="checkbox"/> No				
-- NW --		-- NE --																			
-- SW --		-- SE --																			
<b>5 TYPE OF CASING USED:</b> <input type="checkbox"/> Steel <input checked="" type="checkbox"/> PVC <input type="checkbox"/> Other ..... CASING JOINTS: <input type="checkbox"/> Glued <input type="checkbox"/> Clamped <input type="checkbox"/> Welded <input checked="" type="checkbox"/> Threaded Casing diameter 2 in. to 25 ft., Diameter 2 in. to 70 ft., Diameter ..... in. to ..... ft. Casing height above land surface 12 in., Weight .....lbs./ft., Wall thickness or gauge No. .... TYPE OF SCREEN OR PERFORATION MATERIAL: <input type="checkbox"/> Steel <input type="checkbox"/> Stainless Steel <input checked="" type="checkbox"/> PVC <input type="checkbox"/> Other (Specify) ..... <input type="checkbox"/> Brass <input type="checkbox"/> Galvanized Steel <input type="checkbox"/> None used (open hole) SCREEN OR PERFORATION OPENINGS ARE: <input checked="" type="checkbox"/> Continuous slot <input type="checkbox"/> Mill slot <input type="checkbox"/> Gauze wrapped <input type="checkbox"/> Torch cut <input type="checkbox"/> Drilled holes <input type="checkbox"/> None (open hole) <input type="checkbox"/> Louvered shutter <input type="checkbox"/> Key punched <input type="checkbox"/> Wire wrapped <input type="checkbox"/> Saw cut <input type="checkbox"/> Other (specify) ..... SCREEN-PERFORATED INTERVALS: From 25 ft. to 65 ft., From 70 ft. to 110 ft. From ..... ft. to ..... ft., From ..... ft. to ..... ft. GRAVEL PACK INTERVALS: From 24 ft. to 65 ft., From 69 ft. to 112 ft. From ..... ft. to ..... ft., From ..... ft. to ..... ft.																					
<b>6 GROUT MATERIAL:</b> <input type="checkbox"/> Neat cement <input type="checkbox"/> Cement grout <input checked="" type="checkbox"/> Bentonite <input type="checkbox"/> Other ..... Grout Intervals: From 3 ft. to 24 ft., From 65 ft. to 69 ft., From ..... ft. to ..... ft. What is the nearest source of possible contamination: <input type="checkbox"/> Septic tank <input type="checkbox"/> Lateral lines <input type="checkbox"/> Pit privy <input type="checkbox"/> Livestock pens <input type="checkbox"/> Insecticide storage <input type="checkbox"/> Other (specify below) <input type="checkbox"/> Sewer lines <input type="checkbox"/> Cesspool <input type="checkbox"/> Sewage lagoon <input checked="" type="checkbox"/> Fuel storage <input type="checkbox"/> Abandoned water well <input type="checkbox"/> Watertight sewer lines <input type="checkbox"/> Seepage pit <input type="checkbox"/> Feedyard <input type="checkbox"/> Fertilizer storage <input type="checkbox"/> Oil well/gas well ..... Direction from well ..... Distance from well .....																					
FROM	TO	LITHOLOGIC LOG	FROM	TO	LITHO. LOG (cont.) or PLUGGING INTERVALS																
0	3	Brown Silt	62	79	Gray Silt																
3	15	Gray Silt	79	87	Reddish Yellow Clay																
15	20	Brown Clay	87	92	Yellowish Red Clay																
20	22	Brown Silt	92	94	Pink Silt- Stone																
22	35.5	Gray Silt	94	103	Red Silty Clay																
35.5	42	Brown Clayey Silt	103	106	Reddish Yellow Clay																
42	47	Gray Clay	106	112	Pink Clay																
47	50	Brown Clay																			
50	59	Pink Clay																			
59	62	Pink Silt																			

**7 CONTRACTOR'S OR LANDOWNER'S CERTIFICATION:** This water well was ☒ constructed, ☐ reconstructed, or ☐ plugged under my jurisdiction and was completed on (mo/day/year) 02/14/2012 and this record is true to the best of my knowledge and belief. Kansas Water Well Contractor's License No. 763. This Water Well Record was completed on (mo/day/year) 03/08/2012 under the business name of Peterson Drilling and Testing, Inc. by (signature) 

**INSTRUCTIONS:** Use typewriter or ball point pen. PLEASE PRESS FIRMLY and PRINT clearly. Please fill in blanks and check the correct answers. Send three copies (white, blue, pink) to Kansas Department of Health and Environment, Bureau of Water, Geology Section, 1000 SW Jackson St., Suite 420, Topeka, Kansas 66612-1367. Telephone 785-296-5524. Send one copy to WATER WELL OWNER and retain one for your records. Include fee of \$5.00 for each constructed well. Visit us at <http://www.kdheks.gov/waterwell/index.html>.