


1 LOCATION OF WATER WELL: Fraction SW 1/4 SW 1/4 NW 1/4 Section Number 36 Township Number T 30 S Range Number R 37 E/W

Distance and direction from nearest town or city street address of well if located within city?
13 S, 1 E., and 1/2 N of Ulysses

2 WATER WELL OWNER: Clayton Gerrond
RR#, St. Address, Box #: 1102 S. Monroe Board of Agriculture, Division of Water Resources
City, State, ZIP Code: Hugoton, KS 67951 Application Number: GT006 & 9704

3 LOCATE WELL'S LOCATION WITH AN "X" IN SECTION BOX: 4 DEPTH OF COMPLETED WELL: 370 ft. ELEVATION: 3064

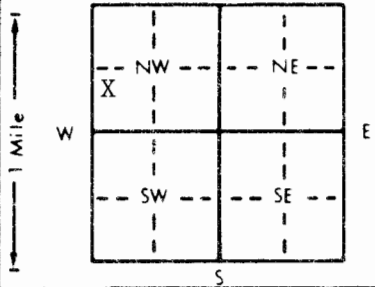

Depth(s) Groundwater Encountered 1. 207 ft. 2. ft. 3. ft.
WELL'S STATIC WATER LEVEL 207 ft. below land surface measured on mo/day/yr
Pump test data Well water was 250 ft. after 72 hours pumping 750 gpm
Est. Yield 1500 gpm Well water was 300 ft. after 3 hours pumping 1200 gpm
Bore Hole Diameter in to ft. and in to ft.
WELL WATER TO BE USED AS:
5 Public water supply 8 Air conditioning 11 Injection well
1 Domestic 3 Feedlot 6 Oil field water supply 9 Dewatering 12 Other (Specify below)
2 Irrigation 4 Industrial 7 Lawn and garden only 10 Monitoring well
Was a chemical/bacteriological sample submitted to Department? Yes No X If yes, mo/day/yr sample was submitted
Water Well Disinfected? Yes X No

5 TYPE OF BLANK CASING USED:
1 Steel 3 RMP (SR) 5 Wrought iron 8 Concrete tile CASING JOINTS: Glued Clamped X
2 PVC 4 ABS 6 Asbestos-Cement 9 Other (specify below) Welded
7 Fiberglass Threaded

Blank casing diameter 16 in. to 310 ft. Dia in. to ft. Dia in. to ft.
Casing height above land surface 12 in. weight 16.151 lbs./ft. Wall thickness or gauge No. SDR21

TYPE OF SCREEN OR PERFORATION MATERIAL:
1 Steel 3 Stainless steel 5 Fiberglass 7 PVC 10 Asbestos-cement
2 Brass 4 Galvanized steel 6 Concrete tile 8 RMP (SR) 11 Other (specify)
12 None used (open hole)

SCREEN OR PERFORATION OPENINGS ARE:
1 Continuous slot 3 Mill slot 5 Gauzed wrapped 8 Saw cut 11 None (open hole)
2 Louvered shutter 4 Key punched 6 Wire wrapped 9 Drilled holes
7 Torch cut 10 Other (specify)

SCREEN-PERFORATED INTERVALS: From 270 ft. to 290 ft. From 310 ft. to 370 ft.
GRAVEL PACK INTERVALS: From 20 ft. to 370 ft.

6 GROUT MATERIAL: 1 Neat cement 2 Cement grout 3 Bentonite 4 Other
Grout intervals: From 0 ft. to 20 ft. From ft. to ft. From ft. to ft.

What is the nearest source of possible contamination:
1 Septic tank 4 Lateral lines 7 Pit privy 10 Livestock pens 14 Abandoned water well
2 Sewer lines 5 Cess pool 8 Sewage lagoon 11 Fuel storage 15 Oil well/Gas well
3 Watertight sewer lines 6 Seepage pit 9 Feedyard 12 Fertilizer storage 16 Other (specify below)
Direction from well? North How many feet? 290

FROM	TO	LITHOLOGIC LOG	FROM	TO	PLUGGING INTERVALS
0	11	Top soil and sandy clay	361	370	Clay, sandy clay & 2' shale
11	16	Sandy clay and little cliche			
16	32	Cliche			
32	49	Sand (fine to medium)			
49	65	Sand & sandy clay			
65	82	Clay & cliche			
82	98	Sand & cliche(hard)			
98	114	Sticky clay			
114	164	Sandy clay			
164	229	Sandy & clay mix			
229	246	Sand(medium to course)& little clay			
246	259	Sand (medium to course)			
259	292	Clay			
292	344	Samd (medium) & 7' clay			
344	361	Sandy clay & 4' sand(medium)			

7 CONTRACTOR'S OR LANDOWNER'S CERTIFICATION: This water well was (1) constructed, (2) reconstructed, or (3) plugged under my jurisdiction and was completed on (mo/day/year) June 20, 1993 and this record is true to the best of my knowledge and belief. Kansas Water Well Contractor's License No. 473 This Water Well Record was completed on (mo/day/yr) July 14, 1994 under the business name of Tyler Water Well Service by (signature) Tyler Gerrond

INSTRUCTIONS: Use typewriter or ball point pen PLEASE PRESS FIRMLY and PRINT clearly. Please fill in blanks, underline or circle the correct answers. Send top three copies to Kansas Department of Health and Environment, Bureau of Water, Topeka, Kansas 66620-0001. Telephone: 913-296-5545. Send one to WATER WELL OWNER and retain one for your records.

66666

OFFICE USE ONLY
T
R
E/W
SEC