

USE TYPEWRITER OR BALL POINT PEN-PRESS FIRMLY, PRINT CLEARLY.

WATER WELL RECORD
KSA 82a-1201-1215


T R EW sec 1/4 1/4 1/4 No.

Kansas State Dept. Of Health
(Water Well Contractors)
Forbes-Bldg. 740
Topeka, Kansas 66620

1 Location of well:	County Grant	Township name Sullivan	Fraction NE NE SW	Section number 17	Town number 30 S	Range number 38 W
---------------------	------------------------	----------------------------------	-----------------------------	-----------------------------	----------------------------	-----------------------------

Distance and direction from nearest town or city: **8 west, 10 south, 1 north, 1 east of Ulysses, Kansas**

3 Owner of well: **Bernard Linke**
Address: **RR2**
Great Bend, Kansas

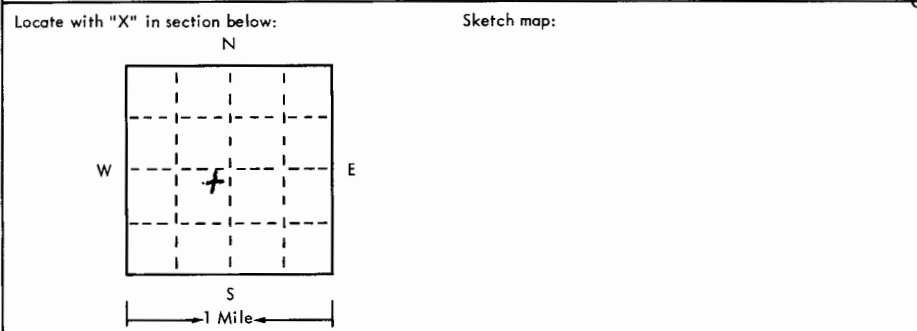

4 Well depth: **333** ft. Date of completion: **2/10/75**
Well diameter **27** in.

5 Cable tool Rotary Driven Dug
 Hollow rod Jetted Bored Reverse rotary

6 Use: Domestic Public supply Industry
 Irrigation Air conditioning Commercial
 Test well

7 Casing: Material **steel** Height: **above**/below
Threaded Welded Surface **12** in.
Diam. **16 inch** Weight **36.8** lbs./ft.
16 in. to **234** ft. depth Drive shoe? Yes No

2	Type and color of material	From	To
	Surface	0	2
	Brown and sandy clay	2	45
	Lime shells and clay (hard)	45	70
	Medium to coarse sand (cemented)	70	88
	Medium to coarse sand	88	133
	Brown sandy clay	133	199
	Sandy clay w/sand strips	199	238
	Medium to coarse sand w/clay breakers	238	269
	Clay	269	271
	Medium to coarse sand w/clay breakers	271	329
	Rainbow clay	329	359
	(use a second sheet if needed)		

8 Screen: Manufacturer **Lakewood**
Type **steel** Dia. **16 inch**
Slot/gauze **3/16** Length **2 inch slot-**
from 234 ft. to 333 ft. length
Fittings: Gravel pack Yes No Size range of material **1/4 to 5/8**

9 Static water level: **200** ft. below land surface Date **1/26/75**

10 Pumping level below land surfaces:
235 ft. after **23.2** hrs. pumping **1583** g.p.m.
ft. after _____ hrs. pumping _____ g.p.m.
Estimated maximum yield **1583** g.p.m.

11 Water sample submitted:
 Yes No Date _____

12 Well head completion:
 Pitless adapter **12** Inches above grade

13 Well grouted? Yes No
 Neat cement Bentonite _____
Depth: From **0** ft. to **10** ft.

14 Nearest source of possible contamination:
ft. **1 mile west** Type **creek**
Well disinfected upon completion? Yes No

15 Pump: Not installed
Manufacturer's name _____
Model number _____ HP _____ Volts _____
Length of drop pipe _____ ft. capacity _____ g.p.m.
Type:
 Submersible Turbine
 Jet Reciprocating
 Centrifugal Other

16 Remarks: elevation **Wheat field**

Topography:
 Hill
 Slope
 Upland
 Valley

17 Water well contractor's certification:
This well was drilled under my jurisdiction and this report is true to the best of my knowledge and belief.
Houck Bros. Drlg. Co. 164
Business name License No.
Address **Box 487 Ulysses, Ks**
Signed **M. Beard** Date **3/20/75**
Authorized representative