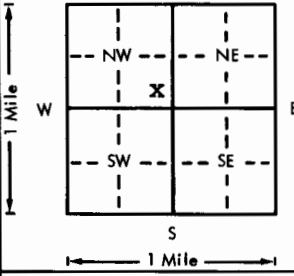
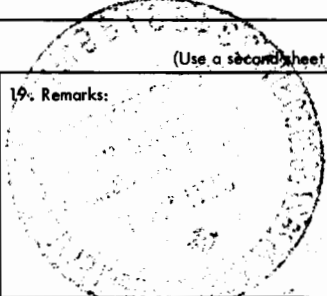


USE TYPEWRITER OR BALL
POINT PEN-PRESS FIRMLY,
PRINT CLEARLY.

WATER WELL RECORD
KSA 82a-1201-1215

Kansas Department of Health and
Environment-Division of Environment
(Water well Contractors)
Topeka, Kansas 66620

1. Location of well:		County Grant	Fraction SE 1/4 SE 1/4 NW 1/4	Section number 23	Township number T 30 S	Range number R 38 E
2. Distance and direction from nearest town or city: 10 S., 4 3/4 W., Street address of well location if in city: 1/4 S. of Ulysses.			3. Owner of well: Milton Fischer R.R. or street: Route 2 City, state, zip code: Ulysses, Kansas 67880			
4. Locate with "X" in section below: 			Sketch map:		6. Bore hole dig. 26 in. Completion date 1-20-77 Well depth 465 ft.	
5. Type and color of material			From		To	
7. Cable tool ☐ Rotary ☐ Driven ☐ Dug ☐ Hollow rod ☐ Jetted ☐ Bored ☒ Reverse rotary			8. Use: ☐ Domestic ☐ Public supply ☐ Industry ☒ Irrigation ☐ Air conditioning ☐ Stock ☐ Lawn ☐ Oil field water ☐ Other			
9. Casing: Material steel Height: Above or below Threaded ☐ Welded ☒ Surface 12 in. RMP ☐ PVC ☐ Weight 36.87 lbs./ft. Dia. 16 in. to 466 ft. depth Wall Thickness: inches or Dia. ☐ in. to ☐ ft. depth gage No. 250			10. Screen: Manufacturer's name Johnson Type galv. Dia. 16" Slot/groove ☐ Length 20 ft. Set between 315-345 ft. and 420-440 ft. Perf: 270-315 ft. and 345-420, 440-465 Gravel pack? yes Size range of material 1/2" down			
11. Static water level: 160 ft. below land surface Date 12-17-76 mo./day/yr.			12. Pumping level below land surfaces: 340 ft. after 6 hrs. pumping 1250 g.p.m. ft. after ☐ hrs. pumping ☐ g.p.m. Estimated maximum yield 1000 g.p.m.			
13. Water sample submitted: ☐ Yes ☒ No Date ☐ mo./day/yr.			14. Well head completion: ☐ Pitless adapter 12 inches above grade			
15. Well grouted? yes With: ☐ Neat cement ☐ Bentonite ☒ Concrete Depth: From 0 ft. to 10 ft.			16. Nearest source of possible contamination: N/A ft. ☐ Direction ☐ Type ☐ Well disinfected upon completion? ☐ Yes ☒ No			
17. Pump: Not installed (used) Manufacturer's name Peerless Model number 12 HP 150 Volts ☐ Length of drop pipe 360 ft. capacity 1000 g.p.m. Type: ☐ Submersible ☒ Turbine ☐ Jet ☐ Reciprocating ☐ Centrifugal ☐ Other			18. Elevation:			
19. Remarks: 			20. Water well contractor's certification: This well was drilled under my jurisdiction and this report is true to the best of my knowledge and belief. Minter-Wilson Drilling Co. 208 Business name Box A Garden City, KS. License No. ☐ Address Box A Garden City, KS. Signed [Signature] Date 9-30-77 Authorized representative			

Forward the white, blue and pink copies to the Department of Health and Environment

Form WWC-5

TEST HOLE LOG

Wagner's

Box 10, Ulysses, Kansas 67880

Water Wells & Test Holes

Phone (316) 356-2396

Test No. 1Date 3-15-1976Otr. NW Sec. 23Twp. 30 Rge. 38Co. GrantLand Owner Milton FischerAddress Ulysses, Kansas

CONSOLIDATED-SALINA

FOOTAGE	Description of Strata
0 - 15	Surface and brown clay
15 - 90	Brown clay
90 - 105	Gyp
105 - 135	Brown clay
135 - 150	Sand
150 - 195	Brown clay
195 - 210	Sand
210 - 240	Sand & brown clay strips...60%
240 - 255	Sand
255 - 285	Sand & brown clay strips...80
285 - 300	Sand: Brown clay 295-300
300 - 315	Coarse sand & brown clay...50%
315 - 330	" " " " " " ...80%
330 - 345	" " " " " " Good
345 - 360	" " " " " " ...50%
360 - 390	Brown clay
390 - 435	Brown shale, lava rock & brown sandstone
435 - 540	Brown shale & some brown sandstone
	Hole at 540 ft.
	cc: R. L. DRILLING, ULYSSES, KANSAS

If you drill this one:

0-270 Plain
 270-315 Perf
 315-345 Screen
 345-420 Perf
 420-440 Screen
 440-465 Perf
 Hole - 465

30

20

330' 1200' GAL

360 8"