MW-3

WATER WELL RECORD Form WWC-5 KSA 82a-1212

1 LOCATION OF WATER WELL: County: GRANT | Fraction: NE ¼ NW ¼ NW ¼ | Section Number: 25 | Township Number: T 30 S | Range Number: R 38 E W

Distance and direction from nearest town or city street address of well if located within city? 8 miles South, then 4 miles west of Ulysses, KS. ~~330 Southwest of [illegible]~~ MW3

2 WATER WELL OWNER: LOREN WITT
RR#, St. Address, Box # : 608 N. West St.
City, State, ZIP Code : Wichita, KS 67203
Board of Agriculture, Division of Water Resources
Application Number:

3 LOCATE WELL'S LOCATION WITH AN "X" IN SECTION BOX:

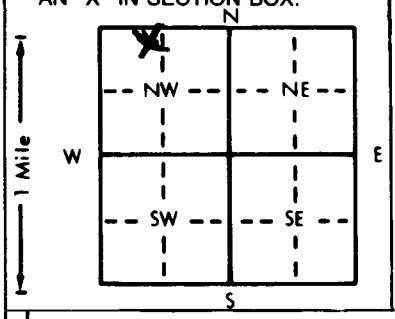

4 DEPTH OF COMPLETED WELL 252 ft. ELEVATION:
Depth(s) Groundwater Encountered 1. ft. 2. ft. 3. ft.
WELL'S STATIC WATER LEVEL 226.42 ft. below land surface measured on mo/day/yr 12-2-94
Pump test data: Well water was ft. after hours pumping gpm
Est. Yield gpm: Well water was ft. after hours pumping gpm
Bore Hole Diameter 7⅞ in. to ft., and in. to ft.
WELL WATER TO BE USED AS: 1 Domestic 2 Irrigation 3 Feedlot 4 Industrial 5 Public water supply 6 Oil field water supply 7 Lawn and garden only 8 Air conditioning 9 Dewatering 10 Monitoring well 11 Injection well 12 Other (Specify below)
Was a chemical/bacteriological sample submitted to Department? Yes No; If yes, mo/day/yr sample was submitted
Water Well Disinfected? Yes No

5 TYPE OF BLANK CASING USED: 1 Steel 2 PVC 3 RMP (SR) 4 ABS 5 Wrought iron 6 Asbestos-Cement 7 Fiberglass 8 Concrete tile 9 Other (specify below)
CASING JOINTS: Glued Clamped Welded Threaded
Blank casing diameter 4 in. to 0 ft., Dia in. to ft., Dia in. to ft.
Casing height above land surface in., weight lbs./ft. Wall thickness or gauge No.

TYPE OF SCREEN OR PERFORATION MATERIAL: 1 Steel 2 Brass 3 Stainless steel 4 Galvanized steel 5 Fiberglass 6 Concrete tile 7 PVC 8 RMP (SR) 9 ABS 10 Asbestos-cement 11 Other (specify) 12 None used (open hole)

SCREEN OR PERFORATION OPENINGS ARE: 1 Continuous slot 2 Louvered shutter 3 Mill slot 4 Key punched 5 Gauzed wrapped 6 Wire wrapped 7 Torch cut 8 Saw cut 9 Drilled holes 10 Other (specify) 11 None (open hole)

SCREEN-PERFORATED INTERVALS: From 252 ft. to 222 ft., From ft. to ft.
From ft. to ft., From ft. to ft.
GRAVEL PACK INTERVALS: From 252 ft. to 220 ft., From ft. to ft.
From ft. to ft., From ft. to ft.

6 GROUT MATERIAL: 1 Neat cement 2 Cement grout 3 Bentonite 4 Other
Grout Intervals: From 218 ft. to 2.25 ft., From ft. to ft., From ft. to ft.

What is the nearest source of possible contamination: 1 Septic tank 2 Sewer lines 3 Watertight sewer lines 4 Lateral lines 5 Cess pool 6 Seepage pit 7 Pit privy 8 Sewage lagoon 9 Feedyard 10 Livestock pens 11 Fuel storage 12 Fertilizer storage 13 Insecticide storage 14 Abandoned water well 15 Oil well/Gas well 16 Other (specify below)
Direction from well? EAST by NORTHeast How many feet? 90

FROM	TO	LITHOLOGIC LOG	FROM	TO	PLUGGING INTERVALS
0	0.5	~~Silty Clay~~ Topsoil	218	216	Bentonite pellets
0.5	18	Silty clay, dark yellowish brown			
18	58	Clay, SAND, FINE, low plasticity			
58	108	Clay, medium plasticity, med. stiff			
108	128	Clayey, SAND, fine, low plasticity			
128	138	SAND, Medium, well graded			
138	158	Clay, medium plasticity, med. stiff			
158	168	SANDY clay FINE, low plasticity			
168	178	Clay, medium plasticity, med. stiff			
178	188	SAND, medium, well graded			
188	252	Clay, med. plasticity, med. stiff			

7 CONTRACTOR'S OR LANDOWNER'S CERTIFICATION: This water well was (1) constructed, (2) reconstructed, or (3) plugged under my jurisdiction and was completed on (mo/day/year) 11-16-94 and this record is true to the best of my knowledge and belief. Kansas Water Well Contractor's License No. 438 This Water Well Record was completed on (mo/day/yr) 12-4-94 under the business name of Huntingdon by (signature) Bernie Tomec

INSTRUCTIONS: Use typewriter or ball point pen. *PLEASE PRESS FIRMLY* and *PRINT* clearly. Please fill in blanks, underline or circle the correct answers. Send top three copies to Kansas Department of Health and Environment, Bureau of Water, Topeka, Kansas 66620-0001. Telephone: 913-296-5545. Send one to WATER WELL OWNER and retain one for your records.

OFFICE USE ONLY