


MW-1

1 LOCATION OF WATER WELL: Fraction NE 1/4 NW 1/4 NW 1/4 Section Number 25 Township Number T 30 S Range Number R 38 E 1

Distance and direction from nearest town or city street address of well if located within city?
8 miles SSW of Ulysses, KS MW-1

2 WATER WELL OWNER: LOREN WITT
 RR#, St. Address, Box #: 608 N. West Street
 City, State, ZIP Code: Wichita, KS 67203
 Board of Agriculture, Division of Water Resources
 Application Number:

3 LOCATE WELL'S LOCATION WITH AN "X" IN SECTION BOX:

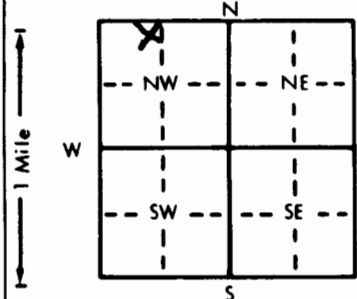

4 DEPTH OF COMPLETED WELL: 245 ft. ELEVATION:

Depth(s) Groundwater Encountered 1. 225.8 ft. 2. 12-2-94 ft. 3. 12-2-94 ft.

WELL'S STATIC WATER LEVEL 225.8 ft. below land surface measured on mo/day/yr 12-2-94




WELL WATER TO BE USED AS: 5 Public water supply 8 Air conditioning 11 Injection well

1 Domestic 3 Feedlot 6 Oil field water supply 9 Dewatering 12 Other (Specify below)

2 Irrigation 4 Industrial 7 Lawn and garden only 10 Monitoring well

Was a chemical/bacteriological sample submitted to Department? Yes No; If yes, mo/day/yr sample was submitted

Water Well Disinfected? Yes No

5 TYPE OF BLANK CASING USED: 5 Wrought iron 8 Concrete tile CASING JOINTS: Glued Welded Clamped Threaded

1 Steel 3 RMP (SR) 6 Asbestos-Cement 9 Other (specify below)

2 PVC 4 ABS 7 Fiberglass

Blank casing diameter 4 in. to 0.5 ft., Dia 4 in. to 215 ft., Dia 4 in. to 215 ft.

Casing height above land surface 4 in., weight 4 lbs./ft. Wall thickness or gauge No. 4

TYPE OF SCREEN OR PERFORATION MATERIAL: 7 PVC 10 Asbestos-cement

1 Steel 3 Stainless steel 5 Fiberglass 8 RMP (SR) 11 Other (specify)

2 Brass 4 Galvanized steel 6 Concrete tile 9 ABS 12 None used (open hole)

SCREEN OR PERFORATION OPENINGS ARE: 5 Gauzed wrapped 8 Saw cut 11 None (open hole)

1 Continuous slot 3 Mill slot 6 Wire wrapped 9 Drilled holes

2 Louvered shutter 4 Key punched 7 Torch cut 10 Other (specify)

SCREEN-PERFORATED INTERVALS: From 245 ft. to 215 ft., From 245 ft. to 215 ft.

GRAVEL PACK INTERVALS: From 245 ft. to 213 ft., From 245 ft. to 213 ft.



6 GROUT MATERIAL: 1 Neat cement 2 Cement grout 3 Bentonite 4 Other

Grout Intervals: From 211 ft. to 15 ft., From 211 ft. to 15 ft., From 211 ft. to 15 ft.

What is the nearest source of possible contamination: 10 Livestock pens 14 Abandoned water well

1 Septic tank 4 Lateral lines 7 Pit privy 11 Fuel storage 15 Oil well/Gas well

2 Sewer lines 5 Cess pool 8 Sewage lagoon 12 Fertilizer storage 16 Other (specify below)

3 Watertight sewer lines 6 Seepage pit 9 Feedyard 13 Insecticide storage

Direction from well? 34 tank basin How many feet? 0

FROM TO LITHOLOGIC LOG FROM TO PLUGGING INTERVALS

0' 0.5' Topsoil 213' 211' Bentonite pellets

5' 100' Clay, low plasticity, olive gray

80' 108' Clay, light sand, low plasticity, light brown

108' 128' Sand, Medium, poorly graded

128' 138' Clay, medium plasticity, med. stiff

138' 148' Sand, medium, poorly graded, med. stiff

148' 158' Sand, med. to fine, well graded

158' 168' Clay, med. to high plasticity, stiff

168' 178' Sand, medium, well graded

178' 188' Clay, sand, FINE, medium plasticity

188' 198' Clay, sand, FINE, low plasticity





7 CONTRACTOR'S OR LANDOWNER'S CERTIFICATION: This water well was (1) constructed, (2) reconstructed, or (3) plugged under my jurisdiction and was

completed on (mo/day/year) 11-16-94 and this record is true to the best of my knowledge and belief. Kansas

Water Well Contractor's License No. 438 This Water Well Record was completed on (mo/day/yr) 11-8-94

under the business name of Huntingdon by (signature) Bonnie Lane