


WATER WELL RECORD Form WWC-5 KSA 82a-1212

1 LOCATION OF WATER WELL: Fraction Section Number Township Number Range Number
 COUNTY: 094 STANTON NW 1/4 NW 1/4 NE 1/4 08 T 30 S R 39 W

Distance and direction from nearest town or city street address of well if located within city?
 FROM BIG BOW; APPX 7 MILES SOUTH & 2 MILES WEST

2 WATER WELL OWNER: LEE SHORE, LP Board of Agriculture, Division of Water Resources
 RR#, St. Address, Box #: 907 DURHAM Application Number: 26,288
 City, State, ZIP code: ULYSSES, KS 67880-

3 LOCATE WELL'S LOCATION WITH AN "X" IN SECTION BOX:

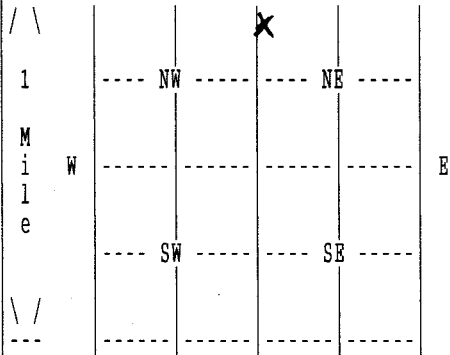

4 DEPTH OF COMPLETED WELL 525 ELEVATION: 0
 Depth(s) Groundwater Encountered 1. 0 ft. 2. 0 ft. 3. 0 ft.

WELL'S STATIC WATER LEVEL 280 ft. below land surface measured on mo/day/yr 07/06/04
 Pump test data: Well water was 323 ft. after 4 hours pumping 1300 gpm
 Estimated Yield 0 gpm: Well water was 0 ft. after 0 hours pumping 0 gpm

Bore Hole Diameter 24 in. to 525 ft., and in. to 0 ft.

WELL WATER TO BE USED AS: 02 IRRIGATION

Was a chemical/bacteriological sample submitted to department? No ;
 If yes, mo/day/yr sample was submitted Water well disinfected? Yes

5 TYPE OF BLANK CASING USED: 01 STEEL CASING JOINTS: WELDED
 Blank casing diameter 16 in. to 525 ft., Dia in. to 0 ft., Dia in. to 0 ft.
 Casing height above land surface 12 in., weight 42 lbs/ft. Wall thickness or gauge No. .250
 TYPE OF SCREEN OR PERFORATION MATERIAL: 01 STEEL
 SCREEN OR PERFORATION OPENINGS ARE: 01 CONT. SLOT

SCREEN PERFORATED INTERVALS: From 296 ft. to 520 ft., From 0 ft. to 0 ft.
 From 0 ft. to 0 ft., From 0 ft. to 0 ft.
 GRAVEL PACK INTERVALS: From 20 ft. to 525 ft., From 0 ft. to 0 ft.
 From 0 ft. to 0 ft., From 0 ft. to 0 ft.

6 GROUT MATERIAL 03 BENTONITE
 Grout Intervals: From 0 ft. to 20 ft., From 0 ft. to 0 ft., From 0 ft. to 0 ft.
 What is the nearest source of possible contamination: 14 ABAND. WELL
 Direction from well? NORTH How many feet? 222

FROM	TO	LITHOLOGIC LOG	FROM	TO	PLUGGING INTERVALS
0	2	02 SILT			RECEIVED
2	30	04 SANDY CLAY 07 FINE SAND 31 CALICHE			SEP 2 6 2004
30	41	05 SAND 13 FINE GRAVEL 14 MED GRAVEL			BUREAU OF WATER
41	60	01 CLAY 05 SAND			
60	79	01 CLAY 20 LIMESTONE			
79	130	05 SAND 13 FINE GRAVEL 01 CLAY			
130	172	05 SAND 13 FINE GRAVEL			
172	182	01 CLAY			
182	280	05 SAND 11 GRAVEL 28 ROCK			
280	303	05 SAND			

7 CONTRACTOR'S OR LANDOWNER'S CERTIFICATION: This water well was Constructed under my jurisdiction and was completed on (mo/day/year) 07/01/04 and this record is true to the best of my knowledge and belief. Kansas Water Well Contractor's License No. 145 This Water Well Record was completed on (mo/day/yr) 08/27/04 under the business name of HENKLE DRILLING & SUPPLY by (signature) -

(Continued)

WATER WELL RECORD Form WWC-5 KSA 82a-1212

1 LOCATION OF WATER WELL: COUNTY: 094 STANTON	Fraction NW 1/4 NW 1/4 NE 1/4	Section Number 08	Township Number T 30 S	Range Number R 39 W
--	----------------------------------	----------------------	---------------------------	------------------------

2 WATER WELL OWNER: LEE SHORE, LP
RR#, St. Address, Box # : 907 DURHAM Board of Agriculture, Division of Water Resources
City, State, ZIP code : ULYSSES, KS 67880- Application Number: 26,288

FROM	TO	LITHOLOGIC LOG
303	311	07 FINE SAND
311	325	05 SAND 01 CLAY
325	345	01 CLAY 20 LIMESTONE
345	359	05 SAND
359	400	07 FINE SAND
400	425	01 CLAY
425	438	07 FINE SAND
438	447	05 SAND
447	463	23 SANDSTONE 31 CALICHE 05 SAND
460	492	23 SANDSTONE
492	504	31 CALICHE 23 SANDSTONE
504	520	31 CALICHE 23 SANDSTONE 20 LIMESTONE
520	534	31 CALICHE 20 LIMESTONE
534	544	20 LIMESTONE 31 CALICHE
544	560	19 SHALE 20 LIMESTONE

7 CONTRACTOR'S OR LANDOWNER'S CERTIFICATION: This water well was Constructed under my jurisdiction and was completed on (mo/day/year) 07/01/04 and this record is true to the best of my knowledge and belief. Kansas Water Well Contractor's License No. 145 This Water Well Record was completed on (mo/day/yr) 08/27/84 under the business name of HENKLE DRILLING & SUPPLY by (signature) *Bruce J. Reichert*