


USE TYPEWRITER OR BALL POINT PEN-PRESS FIRMLY, PRINT CLEARLY.

WATER WELL RECORD
KSA 82a-1201-1215

Kansas Department of Health and Environment-Division of Environment
(Water well Contractors)
Topeka, Kansas 66620

Location of well: County Stanton Fraction NW 1/4 NW 1/4 NE 1/4 Section number 8 Township number T 30 S R 39 E/W

Distance and direction from nearest town or city: 7 south, 3 west, 1/2 south, 1/2 east of Big Bow, KS
Street address of well location if in city:
3. Owner of well: Lee Shore
R.R. or street: Ulysses, Ks. 67880
City, state, zip code:

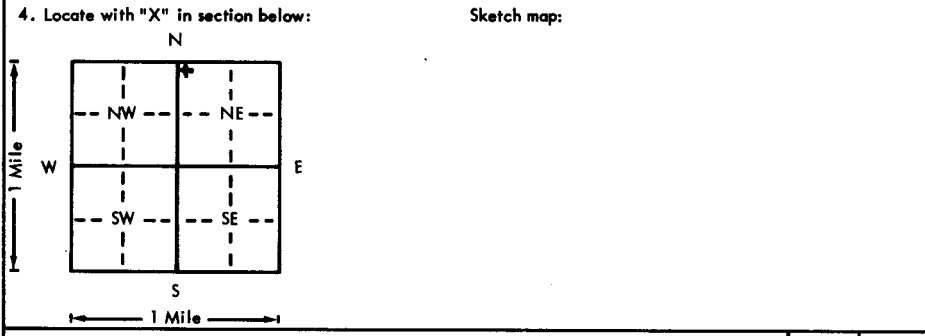

6. Bore hole dia. 27 in. Completion date _____
Well depth 512.2 ft. See Remarks
7. Cable tool Rotary Driven Dug
 Hollow rod Jetted Bored Reverse rotary
8. Use: Domestic Public supply Industry
 Irrigation Air conditioning Stock
 Lawn Oil field water Other
9. Casing: Material steel Height Above or below
Threaded Welded Surface 14 in.
RMP PVC Weight 36.8 lbs./ft.
Dia. 16 in. to 234.3 ft. depth; Wall Thickness: inches or
Dia. _____ in. to _____ ft. depth; gauge No. 219

5. Type and color of material	From	To
Surface	0	2
Very fine to fine sand w/clay breakers	2	30
Medium to coarse sand w/clay breakers	30	50
Sandy clay w/fine sand strips & lime shale	50	77
Embedded sand w/clay breakers	77	120
Medium to coarse sand w/clay breakers	120	167
Sandy clay w/lime shale & fine sand strips	167	180
Medium to coarse sand w/clay breakers from 220	180	298
Sandy clay w/sand strips	298	307
Medium to coarse sand w/clay breakers	307	329
Sandy clay	329	346
Medium to coarse sand w/clay breakers	346	363
Fine to medium sand w/clay breakers	363	428
Medium to coarse sand w/clay breakers	428	448
Brown shale, yellow chalk, sandrock & Dakota	448	466
Brown shale, yellow chalk, sandrock & Cheyenne	466	513

10. Screen: Manufacturer's name Lakewood
Lakewood Pipe of Texas
Type steel Dia. 16"
Slot/gauze 3/16 Length 77.11 ft.
Set between 354.3 ft. and 432.2 ft.
_____ ft. and _____ ft.
Gravel pack? Size range of material 1/2 X 5/8"
11. Static water level: _____ mo./day/yr.
155.6 ft. below land surface Date 6-11-76
12. Pumping level below land surfaces:
182.6 ft. after 6.8 hrs. pumping 1620 g.p.m.
_____ ft. after _____ hrs. pumping _____ g.p.m.
Estimated maximum yield 2800 g.p.m.
13. Water sample submitted: _____ mo./day/yr.
Yes No Date _____
14. Well head completion: NA
 Pitless adapter _____ Inches above grade
15. Well grouted?
With: Neat cement Bentonite Concrete
Depth: From 0 ft. to 10 ft.
16. Nearest source of possible contamination: NA
ft. _____ Direction _____ Type _____
Well disinfected upon completion? Yes No
17. Pump: Not installed
Manufacturer's name _____
Model number _____ HP _____ Volts _____
Length of drop pipe _____ ft. capacity _____ g.p.m.
Type:
 Submersible Turbine
 Jet Reciprocating
 Centrifugal Other

18. Elevation:
Topography:
 Hill
 Slope
 Upland
 Valley
19. Remarks:
W. A. Brown Free-Flo Perforation set between 234.3 and 354.3 and between 432.2 and 512.2'
This well was paid for July 13, 1976 but the pits have not been backfilled

20. Water well contractor's certification:
This well was drilled under my jurisdiction and this report is true to the best of my knowledge and belief.
Houck Bros. Drlg. Co. 164
Business name _____ License No. _____
Address Box 487, Ulysses, Ks.
Signed M. Beard Date 11/3/76
Authorized representative

30 39 W 8 1/4 1/4 1/4