


1 LOCATION OF WATER WELL: County: **Stanton** Fraction: **NW 1/4 NW 1/4 NE 1/4** Section Number: **8** Township Number: **T 30 S** Range Number: **R 39 W**

Distance and direction from nearest town or city street address of well if located within city?
7 south, 2 1/2 west, 3/4 north of Big Bow, KS

2 WATER WELL OWNER: **Lee Shore**
 RR#, St. Address, Box #: **907 N. Durham** Board of Agriculture, Division of Water Resources
 City, State, ZIP Code: **Ulysses, KS 67880** Application Number: **26288**

3 LOCATE WELL'S LOCATION WITH AN "X" IN SECTION BOX:

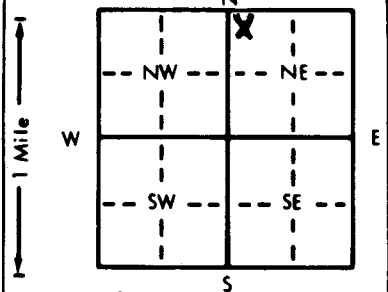

4 DEPTH OF COMPLETED WELL: **512** ft. ELEVATION:

Depth(s) Groundwater Encountered 1. **235** ft. 2. ft. 3. ft.
 WELL'S STATIC WATER LEVEL: **235** ft. below land surface measured on mo/day/yr **3-14-92**
 Pump test data: Well water was **277** ft. after **2** hours pumping **1600** gpm
 Est. Yield **2500** gpm: Well water was **280** ft. after **1** hours pumping **1700** gpm
 Bore Hole Diameter: **26** in. to **512** ft. and in. to ft.
 WELL WATER TO BE USED AS:
 1 Domestic 3 Feedlot 5 Public water supply 8 Air conditioning 11 Injection well
 2 Irrigation 4 Industrial 6 Oil field water supply 9 Dewatering 12 Other (Specify below)
 7 Lawn and garden only 10 Monitoring well
 Was a chemical/bacteriological sample submitted to Department? Yes.....No. **X**.....; If yes, mo/day/yr sample was submitted Water Well Disinfected? Yes **X** No

5 TYPE OF BLANK CASING USED:
 1 Steel 3 RMP (SR) 5 Wrought iron 8 Concrete tile CASING JOINTS: Glued.....Clamped.....
 2 PVC 4 ABS 6 Asbestos-Cement 9 Other (specify below) Welded **X**.....
 7 Fiberglass Threaded.....

Blank casing diameter: **16** in. to **0-290** ft., Dia. **16** in. to **410-490** ft., Dia. in. to ft.
 Casing height above land surface: **12** in., weight **38** lbs./ft. Wall thickness or gauge No. **219**

TYPE OF SCREEN OR PERFORATION MATERIAL:
 1 Steel 3 Stainless steel 5 Fiberglass 7 PVC 10 Asbestos-cement
 2 Brass 4 Galvanized steel 6 Concrete tile 8 RMP (SR) 11 Other (specify).....
 9 ABS 12 None used (open hole)

SCREEN OR PERFORATION OPENINGS ARE:
 1 Continuous slot 3 Mill slot 5 Gauzed wrapped 8 Saw cut 11 None (open hole)
 2 Louvered shutter 4 Key punched 6 Wire wrapped 9 Drilled holes
 7 Torch cut 10 Other (specify).....

SCREEN-PERFORATED INTERVALS: From **290** ft. to **410** ft., From ft. to ft.
 From **490** ft. to **512** ft., From ft. to ft.
 GRAVEL PACK INTERVALS: From **20** ft. to **512** ft., From ft. to ft.
 From ft. to ft., From ft. to ft.

6 GROUT MATERIAL: 1 Neat cement 2 Cement grout 3 Bentonite 4 Other.....
 Grout Intervals: From **0** ft. to **20** ft., From ft. to ft., From ft. to ft., From ft. to ft.

What is the nearest source of possible contamination:
 1 Septic tank 4 Lateral lines 7 Pit privy 10 Livestock pens 14 Abandoned water well
 2 Sewer lines 5 Cess pool 8 Sewage lagoon 11 Fuel storage 15 Oil well/Gas well
 3 Watertight sewer lines 6 Seepage pit 9 Feedyard 12 Fertilizer storage 16 Other (specify below)
 13 Insecticide storage.....

Direction from well? **south** How many feet? **290**

FROM	TO	LITHOLOGIC LOG	FROM	TO	PLUGGING INTERVALS
0	16	top soil & sandy clay	350	359	clay
16	32	limestone & clay	359	361	sandstone (medium)
32	43	sand (medium to coarse) & clay	361	377	sandy clay
43	49	clay & little limestone	377	410	clay & little sand
49	65	clay	410	426	clay & 4' sandstone
65	76	white clay	426	459	sandstone (hard)
76	82	limestone & little clay	459	475	sandy clay
82	98	limestone & cemented sand	475	490	sandstone
98	108	sandy clay	490	505	sandstone & clay mix
108	171	sand	505	512	sandstone
171	196	sandy clay (white)			
196	311	sand (medium)			
311	320	sandstone (medium)			
320	328	clay & 2' sandstone			
328	350	sandstone (medium)			

7 CONTRACTOR'S OR LANDOWNER'S CERTIFICATION: This water well was (1) constructed, (2) reconstructed, or (3) plugged under my jurisdiction and was completed on (mo/day/year) **3-14-92** and this record is true to the best of my knowledge and belief. Kansas Water Well Contractor's License No. **473** This Water Well Record was completed on (mo/day/yr) **3-31-92** under the business name of **Tyler Water Well Service** by (signature) *Tyler Water Well Service*

INSTRUCTIONS: Use typewriter or ball point pen. PLEASE PRESS FIRMLY and PRINT clearly. Please fill in blanks, underline or circle the correct answers. Send top three copies to Kansas Department of Health and Environment, Bureau of Water, Topeka, Kansas 66620-0001. Telephone: 913-296-5545. Send one to WATER WELL OWNER and retain one for your records.

691761908E