


1 LOCATION OF WATER WELL: STANTON
 County: STANTON
 Fraction SW 1/4 SW 1/4 SW 1/4
 Section Number 12
 Township Number T 30 S
 Range Number R 39 E/W

Distance and direction from nearest town or city street address of well if located within city?
 8 miles south...1 mile east of Big Bow, Kansas

2 WATER WELL OWNER: Stewart Farms
 RR#, St. Address, Box #: %Fenwick Pruner
 City, State, ZIP Code: #2 Hazel Lane, Hutchinson, Ks. 67501
 Board of Agriculture, Division of Water Resources
 Application Number: 3225

3 LOCATE WELL'S LOCATION WITH AN "X" IN SECTION BOX:

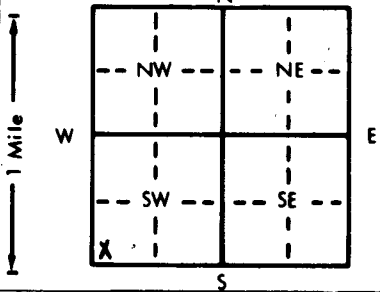

4 DEPTH OF COMPLETED WELL... 352.1 ft. ELEVATION: slope
 Depth(s) Groundwater Encountered 1. 160 ft. 2. ft. 3. ft.
 WELL'S STATIC WATER LEVEL 160 ft. below land surface measured on mo/day/yr 12/4/84
 Pump test data: Well water was WC ft. after hours pumping gpm
 Est. Yield gpm: Well water was WC ft. after hours pumping gpm
 Bore Hole Diameter... 26 in. to 352.1 ft., and in. to ft.
 WELL WATER TO BE USED AS:
 1 Domestic 3 Feedlot 5 Public water supply 8 Air conditioning 11 Injection well
 2 Irrigation 4 Industrial 6 Oil field water supply 9 Dewatering 12 Other (Specify below)
 7 Lawn and garden only 10 Observation well
 Was a chemical/bacteriological sample submitted to Department? Yes.....No.....X.....; If yes, mo/day/yr sample was submitted Water Well Disinfected? Yes No X

5 TYPE OF BLANK CASING USED:
 1 Steel 3 RMP (SR) 5 Wrought iron 8 Concrete tile CASING JOINTS: Glued Clamped
 2 PVC 4 ABS 6 Asbestos-Cement 9 Other (specify below) Welded X
 7 Fiberglass Threaded

Blank casing diameter .16 in. to .247.7 ft., Dia in. to ft., Dia in. to ft.
 Casing height above land surface .18 in., weight 36.85 lbs./ft. Wall thickness or gauge No. 219

TYPE OF SCREEN OR PERFORATION MATERIAL:
 1 Steel 3 Stainless steel 5 Fiberglass 7 PVC 10 Asbestos-cement
 2 Brass 4 Galvanized steel 6 Concrete tile 8 RMP (SR) 11 Other (specify)
 9 ABS 12 None used (open hole)

SCREEN OR PERFORATION OPENINGS ARE:
 1 Continuous slot 3 Mill slot 5 Gauzed wrapped 8 Saw cut 11 None (open hole)
 2 Louvered shutter 4 Key punched 6 Wire wrapped 9 Drilled holes
 7 Torch cut 10 Other (specify)

SCREEN-PERFORATED INTERVALS: From 247.7 ft. to 352.1 ft., From ft. to ft.
 GRAVEL PACK INTERVALS: From 10 ft. to 352.1 ft., From ft. to ft.

6 GROUT MATERIAL: 1 Neat cement 2 Cement grout 3 Bentonite 4 Other
 Grout Intervals: From 0 ft. to 10 ft., From ft. to ft., From ft. to ft.

What is the nearest source of possible contamination:
 1 Septic tank 4 Lateral lines 7 Pit privy 10 Livestock pens 14 Abandoned water well
 2 Sewer lines 5 Cess pool 8 Sewage lagoon 11 Fuel storage 15 Oil well/Gas well
 3 Watertight sewer lines 6 Seepage pit 9 Feedyard 12 Fertilizer storage 16 Other (specify below)
 13 Insecticide storage
 Direction from well? 100 feet northwest How many feet?

FROM	TO	LITHOLOGIC LOG	FROM	TO	LITHOLOGIC LOG
0	2	Surface			
2	60	Clay w/lime shells			
60	100	Medium sand			
100	140	Medium to coarse sand			
140	200	Medium sand w/clay breakers			
200	210	Clay			
210	240	Coarse Fine to medium sand w/clay breakers			
240	320	Fine to medium sand w/cemented strips			
320	345	Medium to coarse sand			
345	380	Clay and yellow chalk			
380	420	Red clay and sandstone			

7 CONTRACTOR'S OR LANDOWNER'S CERTIFICATION: This water well was (1) constructed, (2) reconstructed, or (3) plugged under my jurisdiction and was completed on (mo/day/year) 2/22/85 and this record is true to the best of my knowledge and belief. Kansas Water Well Contractor's License No. 164. This Water Well Record was completed on (mo/day/yr) August 17, 1985 under the business name of Houck Bros. Drig. Co. by (signature) M. Beard

INSTRUCTIONS: Use typewriter or ball point pen, PLEASE PRESS FIRMLY and PRINT clearly. Please fill in blanks, underline or circle the correct answers. Send top three copies to Kansas Department of Health and Environment, Division of Environment, Environmental Geology Section, Topeka, KS 66620. Send one to WATER WELL OWNER and retain one for your records.