

USE TYPEWRITER OR BALL POINT PEN-PRESS FIRMLY, PRINT CLEARLY.

T R EW sec 1/4 1/4 1/4 No.


WATER WELL RECORD
KSA 82a-1201-1215

Kansas State Dept. Of Health
(Water Well Contractors)
Forbes-Bldg. 740
Topeka, Kansas 66620

1 Location of well:	County Stanton	Township name NA	Fraction NW¹/₄ NW¹/₄ NW¹/₄	Section number 14	Town number 305 30S	Range number 30W 39W
---------------------	--------------------------	----------------------------	--	-----------------------------	--	---

Distance and direction from nearest town or city: **8 miles south of Big Bow, Ks.**
Street address of well location if in city:

3 Owner of well:
Address: **Winfred Nicholas
RFD 2, Johnson, Ks.**

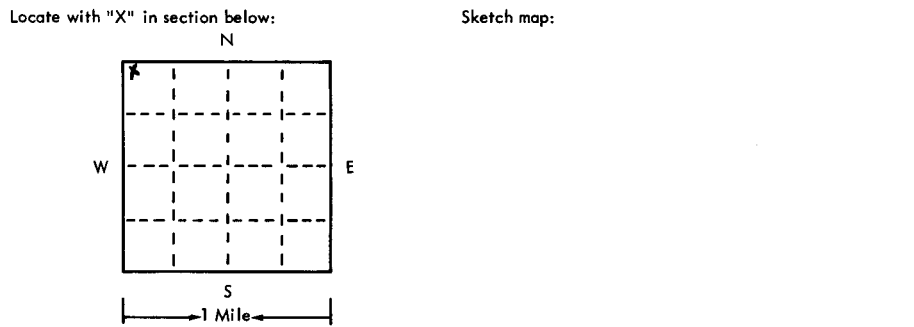

4 Well depth: **300** ft. Date of completion **7-1-75**
Well diameter **9¹/₂** in.

5 Cable tool Rotary Driven Dug
 Hollow rod Jetted Bored Reverse rotary

6 Use: Domestic Public supply Industry
 Irrigation Air conditioning Commercial
 Test well

7 Casing: Material **styrene** Height: **above** below
Threaded Welded Surface **12** in.
Diam. **5** in. O.D. Weight **320** lbs./ft.
0 in. to **220** ft. depth Drive shoe? Yes No
0 in. to **0** ft. depth

2 Type and color of material	From	To
Surface	0	2
Sandy clay	2	15
Fine sand w/clay breakers	15	80
Medium to coarse sand	80	160
Brown clay w/fine sand strips	160	200
Coarse sand and gravel	200	270
Blue clay	270	280
Coarse sand	280	300
(use a second sheet if needed)		

8 Screen:
Manufacturer **Sunflower**
Type **styrene** Dia. **5" o.d.**
 Gauze **1/16** Length **80 ft.**
Set between **220** ft. and **300** ft.
Fittings:
Gravel pack Yes No Size range of material

9 Static water level:
165 ft. below land surface Date **6-26-75**

10 Pumping level below land surfaces:
____ ft. after ____ hrs. pumping ____ g.p.m.
____ ft. after **N.A.** hrs. pumping ____ g.p.m.
Estimated maximum yield ____ g.p.m.

11 Water sample submitted:
 Yes No Date

12 Well head completion:
 Pitless adapter **N.A.** Inches above grade

13 Well grouted? Yes No
 Neat cement Bentonite
Depth: From **0** ft. to **10** ft.

14 Nearest source of possible contamination:
ft. **300** Direction **NW** Type **sewer**
Well disinfected upon completion? Yes No

15 Pump: Not installed
Manufacturer's name _____
Model number _____ HP _____ Volts _____
Length of drop pipe _____ ft. capacity _____ g.m.p.
Type:
 Submersible Turbine
 Jet Reciprocating
 Centrifugal Other

16 Remarks: elevation

Topography:
 Hill
 Slope
 Upland
 Valley

17 Water well contractor's certification:
This well was drilled under my jurisdiction and this report is true to the best of my knowledge and belief.
Houck Bros. Drlg. Co. 164
Business name **Box 487, Ulysses, Ks.** License No.
Address **M. Beard** Date **8-20-75**
Signed **M. Beard** Authorized representative