

sketch


USE TYPEWRITER OR BALL POINT PEN-PRESS FIRMLY, PRINT CLEARLY.

WATER WELL RECORD
KSA 82a-1201-1215

Kansas Department of Health and Environment-Division of Environment (Water well Contractors) Topeka, Kansas 66620

1. Location of well:	County Stanton	Fraction SE 1/4 SE 1/4 SE 1/4	Section number 32	Township number T 30 S R 39	Range number 39
----------------------	--------------------------	---	-----------------------------	---------------------------------------	---------------------------

2. Distance and direction from nearest town or city: 12 miles south Street address of well location if in city: 2 West of Big Bow, Ks.	3. Owner of well: Wesley Ellis R.R. or street: RFD 2 City, state, zip code: Big Bow, Ks. 67832
---	--

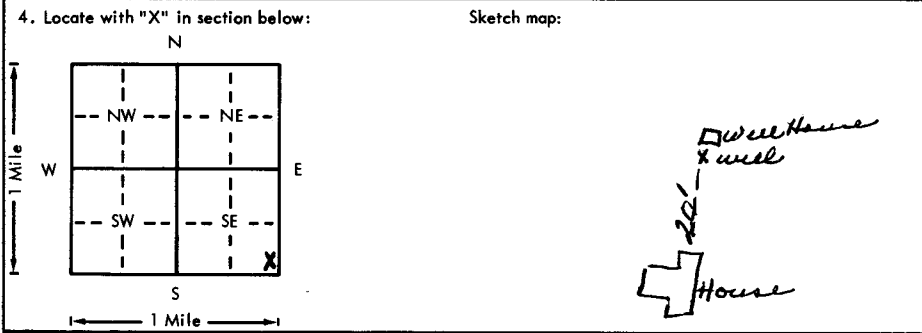

6. Bore hole dia. 9.25 in. Completion date 12-14-76 Well depth 280 ft.
7. <input checked="" type="checkbox"/> Cable tool <input checked="" type="checkbox"/> Rotary <input type="checkbox"/> Driven <input type="checkbox"/> Dug <input type="checkbox"/> Hollow rod <input type="checkbox"/> Jetted <input type="checkbox"/> Bored <input type="checkbox"/> Reverse rotary
8. Use: <input checked="" type="checkbox"/> Domestic <input type="checkbox"/> Public supply <input type="checkbox"/> Industry <input type="checkbox"/> Irrigation <input type="checkbox"/> Air conditioning <input type="checkbox"/> Stock <input type="checkbox"/> Lawn <input type="checkbox"/> Oil field water <input type="checkbox"/> Other
9. Casing: Material styrene Height Above or below Threaded <input type="checkbox"/> Welded <input checked="" type="checkbox"/> Surface 12 in. RMP 5 PVC 180 Weight 12 lbs./ft. Dia. 5 in. to 180 ft. depth! Wall Thickness: inches or Dia. 5 in. to 180 ft. depth! gage No. .320

5. Type and color of material	From	To
Surface	0	2
Clay	2	23
Sandy clay	23	139
Fine sand with clay strips	139	184
Fine to medium sand w/clay breakers	184	225
Clay, yellow chalk, sandstone	225	280
(Use a second sheet if needed)		

10. Screen: Manufacturer's name Sunflower Type styrene Dia. 5" Slot/gauze 1/16 Length 100' Set between 180 ft. and 280 ft. Gravel pack? <input checked="" type="checkbox"/> Size range of material No. 1-8"
11. Static water level: 175 ft. below land surface Date 12/20/76 mo./day/yr. MNC
12. Pumping level below land surfaces: 180 ft. after 5 hrs. pumping 10 g.p.m. Estimated maximum yield 15 g.p.m. MNC
13. Water sample submitted: X Yes No Date
14. Well head completion: <input checked="" type="checkbox"/> Pitless adapter 12 Inches above grade
15. Well grouted? <input checked="" type="checkbox"/> With: <input type="checkbox"/> Neat cement <input checked="" type="checkbox"/> Bentonite <input type="checkbox"/> Concrete Depth: From 0 ft. to 10 ft.
16. Nearest source of possible contamination: ft. 225 Direction South Type sewer line MNC Well disinfected upon completion? <input checked="" type="checkbox"/> Yes <input type="checkbox"/> No
17. Pump: <input checked="" type="checkbox"/> Not installed Manufacturer's name _____ Model number _____ HP _____ Volts _____ Length of drop pipe _____ ft. capacity _____ g.p.m. Type: <input type="checkbox"/> Submersible <input type="checkbox"/> Turbine <input type="checkbox"/> Jet <input type="checkbox"/> Reciprocating <input type="checkbox"/> Centrifugal <input type="checkbox"/> Other

18. Elevation:	19. Remarks:
Topography: <input type="checkbox"/> Hill <input checked="" type="checkbox"/> Slope <input type="checkbox"/> Upland <input type="checkbox"/> Valley	

20. Water well contractor's certification: This well was drilled under my jurisdiction and this report is true to the best of my knowledge and belief. Houck Bros. Drilling Co. 164 Business name License No. _____ Address Box, 487. Ulysses, Ks. Signed M. Beard Date 12/15/76 Authorized representative
--

301
320
32
SE
1/4
1/4
1/4