


1 LOCATION OF WATER WELL: County: Stanton Fraction $\frac{1}{4}$ C $\frac{1}{4}$ NW $\frac{1}{4}$ Section Number 33 Township Number T 30 S Range Number R 39 EW

Distance and direction from nearest town or city street address of well if located within city?
11 1/2 miles SW of Big Bow, KS--

2 WATER WELL OWNER: Trans Pacific Oil Co.
 RR#, St. Address, Box # : 1000 One Main Place #410 Board of Agriculture, Division of Water Resources
 City, State, ZIP Code : Wichita, KS 67202 Application Number: 91-0150

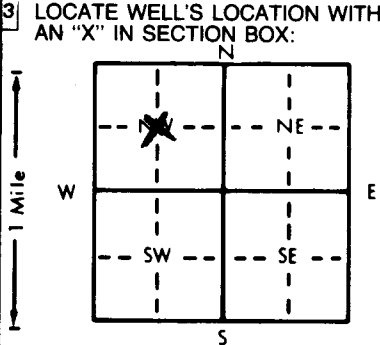

4 DEPTH OF COMPLETED WELL: 300 ft. ELEVATION: _____ ft.
 Depth(s) Groundwater Encountered 1. 175 ft. 2. _____ ft. 3. _____ ft.
 WELL'S STATIC WATER LEVEL 175 ft. below land surface measured on mo/day/yr 02-08-91
 Pump test data: Well water was 180 ft. after 1 hours pumping 90 gpm
 Est. Yield 90 gpm: Well water was _____ ft. after _____ hours pumping _____ gpm
 Bore Hole Diameter 9 1/2 in. to 300 ft., and _____ in. to _____ ft.
 WELL WATER TO BE USED AS: 5 Public water supply 8 Air conditioning 11 Injection well
 1 Domestic 3 Feedlot 6 Oil field water supply 9 Dewatering 12 Other (Specify below)
 2 Irrigation 4 Industrial 7 Lawn and garden only 10 Monitoring well
 Was a chemical/bacteriological sample submitted to Department? Yes _____ No X; If yes, mo/day/yr sample was submitted _____
 Water Well Disinfected? Yes X No _____

5 TYPE OF BLANK CASING USED: 1 Steel 2 PVC 3 RMP (SR) 4 ABS 5 Wrought iron 6 Asbestos-Cement 7 Fiberglass 8 Concrete tile 9 Other (specify below) CASING JOINTS: Glued X Clamped _____ Welded _____ Threaded _____
 Blank casing diameter 5 in. to 300 ft., Dia _____ in. to _____ ft., Dia _____ in. to _____ ft.
 Casing height above land surface 24 in., weight _____ lbs./ft. Wall thickness or gauge No. .032
 TYPE OF SCREEN OR PERFORATION MATERIAL: 1 Steel 2 Brass 3 Stainless steel 4 Galvanized steel 5 Fiberglass 6 Concrete tile 7 PVC 7 8 RMP (SR) 9 ABS 10 Asbestos-cement 11 Other (specify) _____ 12 None used (open hole)
 SCREEN OR PERFORATION OPENINGS ARE: 1 Continuous slot 2 Louvered shutter 3 Mill slot 4 Key punched 5 Gauzed wrapped 6 Wire wrapped 7 Torch cut 8 Saw cut 9 Drilled holes 11 None (open hole) 10 Other (specify) _____
 SCREEN-PERFORATED INTERVALS: From 280 ft. to 300 ft., From _____ ft. to _____ ft.
 From 220 ft. to 260 ft., From _____ ft. to _____ ft.
 GRAVEL PACK INTERVALS: From 180 ft. to 300 ft., From _____ ft. to _____ ft.
 From _____ ft. to _____ ft., From _____ ft. to _____ ft.

6 GROUT MATERIAL: 1 Neat cement 2 Cement grout 3 Bentonite 4 Other Hole plug
 Grout Intervals: From 1 ft. to 20 ft., From _____ ft. to _____ ft., From _____ ft. to _____ ft.
 What is the nearest source of possible contamination: 1 Septic tank 2 Sewer lines 3 Watertight sewer lines 4 Lateral lines 5 Cess pool 6 Seepage pit 7 Pit privy 8 Sewage lagoon 9 Feedyard 10 Livestock pens 11 Fuel storage 12 Fertilizer storage 13 Insecticide storage 14 Abandoned water well 15 Oil well/Gas well 16 Other (specify below) _____
 Direction from well? Northwest How many feet? 250

FROM	TO	LITHOLOGIC LOG	FROM	TO	PLUGGING INTERVALS
0	2	Top soil			
2	33	Brown Clay			
33	48	Sandy Clay			
48	56	Gravel			
56	88	Joint Clay			
88	116	Sandy Clay			
116	147	Joint Clay			
147	215	SAND			
215	225	Joint Clay			
225	235	Sand			
235	253	Clay			
253	290	Fine Sand			
290	300	Blue Clay			

7 CONTRACTOR'S OR LANDOWNER'S CERTIFICATION: This water well was (1) constructed, (2) reconstructed, or (3) plugged under my jurisdiction and was completed on (mo/day/year) 02-08-91 and this record is true to the best of my knowledge and belief. Kansas Water Well Contractor's License No. KWCL-430 This Water Well Record was completed on (mo/day/yr) 02-08-91 under the business name of Howard Drlg. Co. Box 806 Beaver, OK 73938 (signature) _____

INSTRUCTIONS: Use typewriter or ball point pen. PLEASE PRESS FIRMLY and PRINT clearly. Please fill in blanks, underline or circle the correct answers. Send top three copies to Kansas Department of Health and Environment, Bureau of Water, Topeka, Kansas 66620-7320. Telephone: 913-296-5545. Send one to WATER WELL OWNER and retain one for your records.