


1 LOCATION OF WATER WELL: Fraction NW 1/4 NW 1/4 SW 1/4 Section Number 23 Township Number T 30 S Range Number R 39 E W
 County: STANTON

Distance and direction from nearest town or city street address of well if located within city?
From Big Bow: 10 1/2 miles S. & E. into
 2 WATER WELL OWNER: Parker Well Service
 RR#, St. Address, Box # : P.O. Box 638 Board of Agriculture, Division of Water Resources
 City, State, ZIP Code : Johnson, Kansas 67855 Application Number:

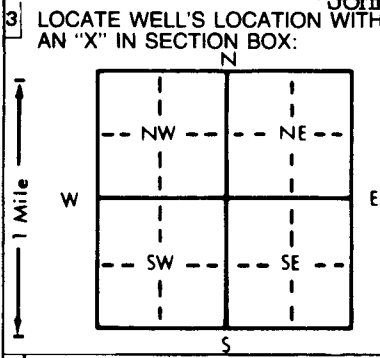

4 DEPTH OF COMPLETED WELL... 380' ft. ELEVATION: ft.
 Depth(s) Groundwater Encountered 1. 200 ft. 2. ft. 3. ft.
 WELL'S STATIC WATER LEVEL . . . 200 ft. below land surface measured on mo/day/yr . . . 10-12-94
 Pump test data: Well water was . . . 210 ft. after . . . 1 . . . hours pumping . . . 90 gpm
 Est. Yield 90 gpm: Well water was ft. after hours pumping gpm
 Bore Hole Diameter . . . 9 1/2 . . . in. to . . . 380' . . . ft., and in. to ft.
 WELL WATER TO BE USED AS: 5 Public water supply 8 Air conditioning 11 Injection well
 1 Domestic 3 Feedlot 6 Oil field water supply 9 Dewatering 12 Other (Specify below)
 2 Irrigation 4 Industrial 7 Lawn and garden only 10 Monitoring well
 Was a chemical/bacteriological sample submitted to Department? Yes.....No..... If yes, mo/day/yr sample was submitted
 Water Well Disinfected? Yes No

5 TYPE OF BLANK CASING USED: 5 Wrought iron 8 Concrete tile CASING JOINTS: Glued Clamped
 1 Steel 3 RMP (SR) 6 Asbestos-Cement 9 Other (specify below) Welded
 2 PVC 4 ABS 7 Fiberglass Threaded
 Blank casing diameter 5" in. to 380' ft., Dia in. to ft., Dia in. to ft.
 Casing height above land surface 24 in., weight 2.902 lbs./ft. Wall thickness or gauge No. 5" SDR 21
 TYPE OF SCREEN OR PERFORATION MATERIAL: 7 PVC 10 Asbestos-cement
 1 Steel 3 Stainless steel 5 Fiberglass 8 RMP (SR) 11 Other (specify)
 2 Brass 4 Galvanized steel 6 Concrete tile 9 ABS 12 None used (open hole)
 SCREEN OR PERFORATION OPENINGS ARE: 5 Gauzed wrapped 8 Saw cut 11 None (open hole)
 1 Continuous slot 3 Mill slot 6 Wire wrapped 9 Drilled holes
 2 Louvered shutter 4 Key punched 7 Torch cut 10 Other (specify)
 SCREEN-PERFORATED INTERVALS: From 340' ft. to 380' ft., From ft. to ft.
 From ft. to ft., From ft. to ft.
 GRAVEL PACK INTERVALS: From 280' ft. to 380' ft., From ft. to ft.
 From ft. to ft., From ft. to ft.

6 GROUT MATERIAL: 1 Neat cement 2 Cement grout 3 Bentonite 4 Other HOLE PLUG
 Grout Intervals: From 1 ft. to 20 ft., From ft. to ft., From ft. to ft.
 What is the nearest source of possible contamination: 10 Livestock pens 14 Abandoned water well
 1 Septic tank 4 Lateral lines 7 Pit privy 11 Fuel storage 15 Oil well/Gas well
 2 Sewer lines 5 Cess pool 8 Sewage lagoon 12 Fertilizer storage 16 Other (specify below)
 3 Watertight sewer lines 6 Seepage pit 9 Feedyard 13 Insecticide storage
 Direction from well? How many feet?

FROM	TO	LITHOLOGIC LOG	FROM	TO	PLUGGING INTERVALS
0	4	Top Soil	372	380	Clay with Red Bed Streaks
4	12	Sandy Clay			
12	46	Brown Clay			
46	57	Sandy Clay			
57	73	Sandy Clay w/sand stone			
73	104	Sand & Sand Stone			
104	155	Sand & Gravel			
155	164	Sand Clay & Sand Stone			
164	180	Gravel & Sand Stone			
180	204	Sand & Gravel			
204	258	Clay			
258	267	Sandy Clay w/Sand Streaks			
267	283	Sand & Gravel			
283	290	Clay			
290	372	Sand & Gravel w/Clay Streaks			

7 CONTRACTOR'S OR LANDOWNER'S CERTIFICATION: This water well was (1) constructed, (2) reconstructed, or (3) plugged under my jurisdiction and was completed on (mo/day/year) 10-11-94 and this record is true to the best of my knowledge and belief. Kansas Water Well Contractor's License No. KWWCL-430 This Water Well Record was completed on (mo/day/yr) 10-11-94 under the business name of HOWARD DRIG. CO. BOX 806 Beaver, Ok. 73932 by (signature) *[Signature]*

INSTRUCTIONS: Use typewriter or ball point pen. PLEASE PRESS FIRMLY and PRINT clearly. Please fill in blanks, underline or circle the correct answers. Send three copies to Kansas Department of Health and Environment, Bureau of Water, Topeka, Kansas 66620-0001. Telephone: 913-296-5545. Send one to WATER WELL OWNER and retain one for your records.