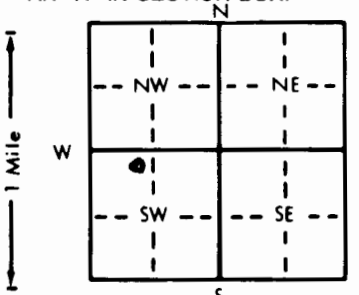


1 LOCATION OF WATER WELL: County: <u>SUMNER</u>		Fraction <u>NE 1/4 NW 1/4 SW 1/4</u>	Section Number <u>1</u>	Township Number <u>T 30S S</u>	Range Number <u>R 4W E/W</u>																								
Distance and direction from nearest town or city street address of well if located within city? <u>3 MILES WEST OF VIOLA ON HIGHWAY 42</u> <u>MW2</u>																													
2 WATER WELL OWNER: <u>McConnell AFB 40 TETRA TECH, INC.</u> RR#, St. Address, Box #: <u>10 E. CAMBRIDGE CIRCLE DR. STE 130</u> City, State, ZIP Code: <u>KANSAS CITY, KS 66103</u> Board of Agriculture, Division of Water Resources Application Number:																													



<table border="1"><thead><tr><th>FROM</th><th>TO</th><th>LITHOLOGIC LOG</th><th>FROM</th><th>TO</th><th>PLUGGING INTERVALS</th></tr></thead><tbody><tr><td>0.0</td><td>17.0</td><td>BLACK, BROWN + GRAY SILTY CLAY - MOIST, SOFT FILL MATERIAL</td><td></td><td></td><td></td></tr><tr><td>17.0</td><td>22.0</td><td>RED, SILTY CLAY - MOIST, WET, SOFT</td><td></td><td></td><td></td></tr><tr><td>22.0</td><td>36.5</td><td>RED SAND & LARGE GRAVEL</td><td></td><td></td><td></td></tr>
7 CONTRACTOR'S OR LANDOWNER'S CERTIFICATION: This water well was <u>(1)</u> constructed, <u>(2)</u> reconstructed, or <u>(3)</u> plugged under my jurisdiction and was completed on (mo/day/year) <u>9-29-95</u> and this record is true to the best of my knowledge and belief. Kansas Water Well Contractor's License No. <u>551</u> This Water Well Record was completed on (mo/day/yr) <u>10-20-95</u> under the business name of <u>ASSOCIATED ENVIRONMENTAL INDUSTRIES</u> by (signature) <u>[Signature]</u>																													
INSTRUCTIONS: Use typewriter or ball point pen. PLEASE PRESS FIRMLY and PRINT clearly. Please fill in blanks, underline or circle the correct answers. Send top three copies to Kansas Department of Health and Environment, Bureau of Water, Topeka, Kansas 66620-0001. Telephone: 913-296-5545. Send one to WATER WELL OWNER and retain one for your records.																													

OFFICE USE ONLY

T

R

E/W

SEC.

1/4

1/4

1/4