

1 LOCATION OF WATER WELL:	Fraction	Section Number	Township Number	Range Number
County: <u>Sumner</u>	<u>NW 1/4 NE 1/4 NE 1/4</u>	<u>5</u>	<u>T 30 S. S</u>	<u>R 4 W E/W</u>

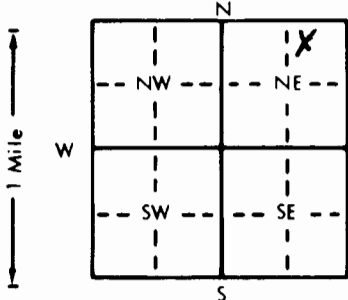
Distance and direction from nearest town or city street address of well if located within city?

1 mile north and 3/8 West of Suppesville, Kansas

2 WATER WELL OWNER:	Board of Agriculture, Division of Water Resources
RR#, St. Address, Box # :	Application Number:
City, State, ZIP Code :	

Brian KoehlerP.O. Box 256Argonia, KS 67004

3 LOCATE WELL'S LOCATION WITH AN "X" IN SECTION BOX:	4 DEPTH OF COMPLETED WELL	ELEVATION:
--	---------------------------	------------

63 ft. NADepth(s) Groundwater Encountered 1. none ft. 2. ft. 3. ft.WELL'S STATIC WATER LEVEL NA ft. below land surface measured on mo/day/yr

Pump test data: Well water was ft. after hours pumping gpm

Est. Yield gpm: Well water was ft. after hours pumping gpm

Bore Hole Diameter 5 in. to 63 ft. and in. to ft.

WELL WATER TO BE USED AS:

1 Domestic 3 Feedlot 6 Oil field water supply 9 Dewatering 12 Other (Specify below)

2 Irrigation 4 Industrial 7 Lawn and garden only 10 Monitoring well

Was a chemical/bacteriological sample submitted to Department? Yes No X; If yes, mo/day/yr sample was submittedWater Well Disinfected? Yes (No)

5 TYPE OF BLANK CASING USED:	5 Wrought iron	8 Concrete tile	CASING JOINTS: Glued
------------------------------	----------------	-----------------	----------------------

1 Steel 3 RMP (SR)

2 PVC 4 ABS

6 Asbestos-Cement

7 Fiberglass

9 Other (specify below)

none, dry hole

Clamped

Welded

Threaded

Blank casing diameter 7.99 in. to ft. Dia in. to ft. Dia in. to ft.Casing height above land surface 0 in. weight lbs./ft. Wall thickness or gauge No.

TYPE OF SCREEN OR PERFORATION MATERIAL:

1 Steel 3 Stainless steel

2 Brass 4 Galvanized steel

5 Fiberglass

6 Concrete tile

7 PVC

8 RMP (SR)

9 ABS

10 Asbestos-cement

11 Other (specify) NA

12 None used (open hole)

SCREEN OR PERFORATION OPENINGS ARE:

1 Continuous slot 3 Mill slot

2 Louvered shutter 4 Key punched

5 Gauzed wrapped

6 Wire wrapped

7 Torch cut 999

8 Saw cut

9 Drilled holes

10 Other (specify) NA

11 None (open hole)

SCREEN-PERFORATED INTERVALS: From 999 ft. to 999 ft. From ft. to ft. From ft. to ft.

GRAVEL PACK INTERVALS: From ft. to ft. From ft. to ft. From ft. to ft.

6 GROUT MATERIAL:	1 Neat cement	2 Cement grout	3 Bentonite	4 Other
-------------------	---------------	----------------	-------------	---------

Grout Intervals: From 63 ft. to 10 ft. From 10 ft. to 3 ft. From ft. to ft.

What is the nearest source of possible contamination:

1 Septic tank 4 Lateral lines

2 Sewer lines 5 Cess pool

3 Watertight sewer lines 6 Seepage pit

7 Pit privy

8 Sewage lagoon

9 Feedyard

10 Livestock pens

11 Fuel storage

12 Fertilizer storage

13 Insecticide storage

14 Abandoned water well

15 Oil well/Gas well

16 Other (specify below)

none

Direction from well?

How many feet?

FROM	TO	LITHOLOGIC LOG	FROM	TO	PLUGGING INTERVALS
			<u>63'</u>	<u>10'</u>	<u>Bentonite Slurry 9.4 #/gal</u>
			<u>10'</u>	<u>3'</u>	<u>Cement grout</u>
			<u>3'</u>	<u>0</u>	<u>Clays</u>

7 CONTRACTOR'S OR LANDOWNER'S CERTIFICATION: This water well was (1) constructed, (2) reconstructed, or (3) plugged under my jurisdiction and was completed on (mo/day/year) <u>8-1-96</u> and this record is true to the best of my knowledge and belief. Kansas Water Well Contractor's License No. <u>612</u> This Water Well Record was completed on (mo/day/yr) <u>8-17-96</u> under the business name of <u>Schmidt Dalg. Co.</u> by (signature) <u>Ralph D. Schmidt</u>
--

INSTRUCTIONS: Use typewriter or ball point pen. PLEASE PRESS FIRMLY and PRINT clearly. Please fill in blanks, underline or circle the correct answers. Send top three copies to Kansas Department of Health and Environment, Bureau of Water, Topeka, Kansas 66620-0001. Telephone: 913-296-5545. Send one to WATER WELL OWNER and retain one for your records.