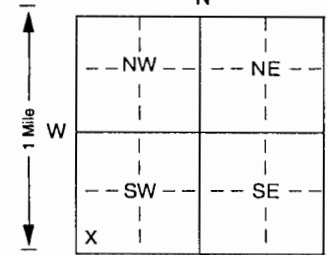


1 LOCATION OF WATER WELL:		WATER WELL RECORD Form WWC-5		KSA 82a-1212 ID No.		Section Number		Township Number		Range Number	
County: Sumner		SW 1/4 SW 1/4 SW 1/4		27		T 30		S		R 4 E W	
Distance and direction from nearest town or city street address of well if located within city? Approximately 1/2 mile north and 5 1/2 miles west of Conway Springs											
2 WATER WELL OWNER: City of Conway Springs RR#, St. Address, Box #: 208 W. Spring - P.O. Box 187 City, State, ZIP Code: Conway Springs, KS 67031 Board of Agriculture, Division of Water Resources Application Number:											
3 LOCATE WELL'S LOCATION WITH AN "X" IN SECTION BOX:		4 DEPTH OF COMPLETED WELL 84 ft. ELEVATION: unknown									
		Depth(s) Groundwater Encountered 1 ft. 2 ft. 3 ft. WELL'S STATIC WATER LEVEL 23 ft. below land surface measured on mo/day/yr 8-30-04 Pump test data: Well water was not checked ft. after hours pumping gpm Est. Yield unknown gpm: Well water was ft. after hours pumping gpm Bore Hole Diameter 5 in. to 85 ft., and in. to ft. WELL WATER TO BE USED AS: 5 Public water supply 8 Air conditioning 11 Injection well 1 Domestic 3 Feedlot 6 Oil field water supply 9 Dewatering 12 Other (specify below) 2 Irrigation 4 Industrial 7 Domestic (lawn & garden) 10 Monitoring well Observation Well Was a chemical/bacteriological sample submitted to Department? Yes No If yes, mo/day/yrs sample was submitted Water Well Disinfected? Yes No									
5 TYPE OF BLANK CASING USED: 1 Steel 3 RMP (SR) 5 Wrought iron 8 Concrete tile CASING JOINTS: Glued Clamped 2 PVC 4 ABS 6 Asbestos-Cement 9 Other (specify below) Welded Blank casing diameter 2 in. to 62 ft., Dia in. to ft., Dia in. to ft. Casing height above land surface 24 in., weight .44 lbs./ft. Wall thickness or gauge No .091 TYPE OF SCREEN OR PERFORATION MATERIAL: 7 PVC 10 Asbestos-cement 1 Steel 3 Stainless steel 5 Fiberglass 8 RMP (SR) 11 Other (specify) 2 Brass 4 Galvanized steel 6 Concrete tile 9 ABS 12 None used (open hole) SCREEN OR PERFORATION OPENINGS ARE: 5 Gauzed wrapped 8 Saw cut 11 None (open hole) 1 Continuous slot 3 Mill slot 6 Wire wrapped 9 Drilled holes 2 Louvered shutter 4 Key punched 7 Torch cut 10 Other (specify) SCREEN-PERFORATED INTERVALS: From 62 ft. to 82 ft., From ft. to ft. GRAVEL PACK INTERVALS: From 60 ft. to 85 ft., From ft. to ft. From ft. to ft.											
6 GROUT MATERIAL: 1 Neat cement Sand 2 Cement grout 3 Bentonite 4 Other Bentonite Holeplug Grout Intervals: From 20 ft. to 55 ft., From 0 ft. to 20 ft., From 55 ft. to 60 ft. What is the nearest source of possible contamination: 1 Septic tank 4 Lateral lines 7 Pit privy 10 Livestock pens 14 Abandoned water well 2 Sewer lines 5 Cess pool 8 Sewage lagoon 11 Fuel storage 15 Oil well/Gas well 3 Watertight sewer lines 6 Seepage pit 9 Feedyard 12 Fertilizer storage 16 Other (specify below) None known Direction from well? How many feet?											
7 CONTRACTOR'S OR LANDOWNER'S CERTIFICATION: This water well was (1) constructed (2) reconstructed or (3) plugged under my jurisdiction and was completed on (mo/day/year) 8-30-04 and this record is true to the best of my knowledge and belief. Kansas Water Well Contractor's License No 185 This Water Well Record was completed on (mo/day/yr) 9-3-04 under the business name of Clarke Well & Equipment, Inc. by (signature)											
INSTRUCTIONS: Use typewriter or ball point pen. PLEASE PRESS FIRMLY and PRINT clearly. Please fill in blanks, underline or circle the correct answers. Send top three copies to Kansas Department of Health and Environment, Bureau of Water, Topeka, Kansas 66620-0001. Telephone 785-296-5524. Send one to WATER WELL OWNER and retain one for your records. Fee of \$5.00 for each constructed well.											