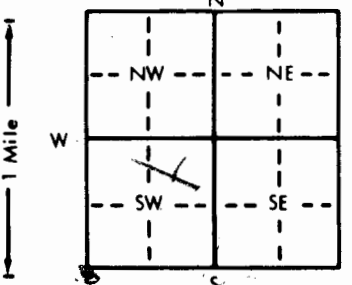


1 LOCATION OF WATER WELL:		Fraction	Section Number	Township Number	Range Number
County: <u>Sumner</u>		<u>40E</u> $\frac{1}{4}$ NW $\frac{1}{4}$ SW $\frac{1}{4}$	<u>33</u>	T <u>30</u> S	R <u>04W</u> EW
Distance and direction from nearest town or city street address of well if located within city? <u>Milton</u> <u>4 1/2 miles South</u>					
2 WATER WELL OWNER: <u>Jennella M. Stitt</u> RR#, St. Address, Box #: <u>938 N Argonia Rd</u> City, State, ZIP Code: <u>Milton Kansas 67106</u> Board of Agriculture, Division of Water Resources Application Number:					
3 LOCATE WELL'S LOCATION WITH AN "X" IN SECTION BOX:		4 DEPTH OF COMPLETED WELL: <u>60'</u> ft. ELEVATION:			
		Depth(s) Groundwater Encountered 1. ft. 2. ft. 3. ft. WELL'S STATIC WATER LEVEL <u>48'</u> ft. below land surface measured on mo/day/yr <u>4/06</u> Pump test data: Well water was ft. after hours pumping gpm Est. Yield gpm: Well water was ft. after hours pumping gpm Bore Hole Diameter in. to ft., and in. to ft. WELL WATER TO BE USED AS: 5 Public water supply 8 Air conditioning 11 Injection well 1 Domestic 3 Feedlot 6 Oil field water supply 9 Dewatering 12 Other (Specify below) 2 Irrigation 4 Industrial <u>0</u> Lawn and garden only 10 Monitoring well Was a chemical/bacteriological sample submitted to Department? Yes.....No.....; If yes, mo/day/yr sample was sub- mitted Water Well Disinfected? Yes No			
5 TYPE OF BLANK CASING USED: 1 Steel 3 RMP (SR) 5 Wrought iron 8 Concrete tile CASING JOINTS: Glued Clamped <u>2 PVC</u> 4 ABS 6 Asbestos-Cement 9 Other (specify below) Welded 7 Fiberglass Threaded Blank casing diameter in. to ft., Dia in. to ft., Dia in. to ft. Casing height above land surface in., weight lbs./ft. Wall thickness or gauge No. TYPE OF SCREEN OR PERFORATION MATERIAL: 1 Steel 3 Stainless steel 5 Fiberglass 7 PVC 10 Asbestos-cement 2 Brass 4 Galvanized steel 6 Concrete tile 8 RMP (SR) 11 Other (specify) 9 ABS 12 None used (open hole) SCREEN OR PERFORATION OPENINGS ARE: 1 Continuous slot 3 Mill slot 5 Gauzed wrapped 8 Saw cut 11 None (open hole) 2 Louvered shutter 4 Key punched 6 Wire wrapped 9 Drilled holes 7 Torch cut 10 Other (specify) SCREEN-PERFORATED INTERVALS: From ft. to ft., From ft. to ft. GRAVEL PACK INTERVALS: From ft. to ft., From ft. to ft. From ft. to ft., From ft. to ft.					
6 GROUT MATERIAL: 1 Neat cement <u>2 Cement grout</u> 3 Bentonite 4 Other Grout intervals: From ft. to ft., From ft. to ft., From ft. to ft. What is the nearest source of possible contamination: 1 Septic tank 4 Lateral lines 7 Pit privy <u>10 Livestock pens</u> 14 Abandoned water well 2 Sewer lines 5 Cess pool 8 Sewage lagoon 11 Fuel storage 15 Oil well/Gas well 3 Watertight sewer lines 6 Seepage pit 9 Feedyard 12 Fertilizer storage 16 Other (specify below) 13 Insecticide storage Direction from well? How many feet? <u>900'</u> FROM TO LITHOLOGIC LOG FROM TO PLUGGING INTERVALS <u>40' 48'</u> <u>sand & gravel</u> <u>48' 6'</u> <u>clays</u> <u>6' 3'</u> <u>grout</u>					
7 CONTRACTOR'S OR LANDOWNER'S CERTIFICATION: This water well was (1) constructed, (2) reconstructed, or (3) plugged under my jurisdiction and was completed on (mo/day/year) <u>4/06</u> and this record is true to the best of my knowledge and belief. Kansas Water Well Contractor's License No. This Water Well Record was completed on (mo/day/yr) <u>4/06</u> under the business name of by (signature) <u>Jennella Stitt</u>					