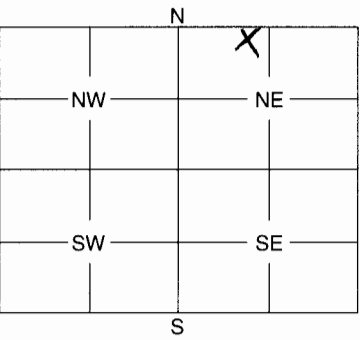


1	LOCATION OF WATER WELL: County: <u>Sumner</u>	Fraction <u>NE, NW, NE</u> $\frac{1}{4}$ $\frac{1}{4}$ $\frac{1}{4}$	Section Number <u>1</u>	Township Number <u>30 South</u>	Range Number <u>04</u>	EW
---	--	--	----------------------------	------------------------------------	---------------------------	----

Distance and direction from nearest town or city street address of well if located within city?

2	WATER WELL OWNER: <u>RAYMOND &amp; MARIE SMALL</u> RR #, St. Address, Box #: <u>90 JOE SLECHTA</u> City, State, ZIP Code: <u>1363 W STATE RD 42</u> <u>CONWAY SPRINGS KS 67031</u>	Board of Agriculture, Division of Water Resources Application Number:
---	---	--

3	MARK WELL'S LOCATION WITH AN "X" IN SECTION BOX: 	4	DEPTH OF WELL ..... <u>44 1/2</u> ft. WELL'S STATIC WATER LEVEL ..... <u>17</u> ft. WELL WAS USED AS: 1 Domestic 2 Irrigation 3 Feedlot 4 Industrial 5 <u>Public Water Supply</u> 6 Oil Field Water Supply 7 Domestic (Lawn & Garden) 8 Air Conditioning 9 Dewatering 10 Monitoring Well 11 Injection Well 12 Other ..... Was a chemical / bacteriological sample submitted to Department? Yes ..... No <u>X</u> ..... If yes, mo/day/yr sample was submitted ..... Water Well Disinfected: Yes <u>X</u> No .....
---	---	---	--

5	TYPE OF BLANK CASING USED: 1 <u>Steel</u> 3 RMP (SR) 5 Wrought 7 Fiberglass 9 Other (Specify below) 2 PVC 4 ABS 6 Asbestos-Cement 8 Concrete Tile Blank casing diameter ..... <u>10</u> in. Was casing pulled? Yes ..... No <u>X</u> ..... If yes, how much <u>CUT OFF</u> Casing height above/below land surface ..... <u>6.5</u> in.
---	--

6	GROUT PLUG MATERIAL: 1 Neat cement 2 <u>Cement grout</u> 3 Bentonite 4 Other ..... Grout Plug Intervals: From ..... ft. to ..... ft., From ..... ft. to ..... ft., From ..... ft. to ..... ft. What is the nearest source of possible contamination: 1 <u>Septic tank</u> 6 Seepage pit 11 Fuel storage 16 Other (specify below) 2 Sewer lines 7 Pit privy 12 Fertilizer storage 3 Watertight sewer lines 8 Sewage lagoon 13 Insecticide storage 4 Lateral lines 9 Feedyard 14 Abandoned water well 5 Cess pool 10 Livestock pens 15 Oil well/Gas well Direction from well? <u>NNE</u> How many feet? <u>3/8 MILE</u>
---	---

FROM	TO	PLUGGING MATERIALS
<u>14 1/2</u>	<u>28</u>	<u>GRAVEL</u>
<u>28</u>	<u>36</u>	<u>CLAY SOIL</u>
<u>36</u>	<u>39</u>	<u>CEMENT GROUT</u>
<u>39</u>	<u>44 1/2</u>	<u>CUT OFF 36" BELOW GROUND</u>

BUILDING REMOVED  
& PIPE CUT 36"  
BELOW GROUND - SITE  
FILLED & LEVELED  
11-3-2007

7	CONTRACTOR'S OF LANDOWNER'S CERTIFICATION: This water well was plugged under my jurisdiction and was completed on (mo/day/year) ..... <u>10-26-2007</u> ..... and this record is true to the best of my knowledge and belief. Kansas Water Well Contractor's License No. <u>10-30-07</u> under the business name of <u>JOE SLECHTA</u> (LIENANT FOR SMALLS) by (signature) <u>Joe Slechta</u>
---	--

INSTRUCTIONS: Use typewriter or ball point pen. Please press firmly and print clearly. Please fill in blanks, underline or circle the correct answers. Send top three copies to Kansas Department of Health and Environment, Bureau of Water, Geology Section, 1000 SW Jackson St., Ste. 420, Topeka, Kansas 66612-1367. Telephone: 785/296-5522. Send one to Water Well Owner and retain one for your records.