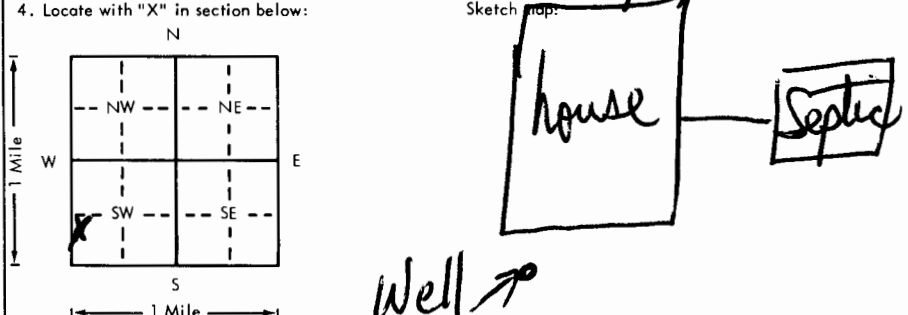


USE TYPEWRITER OR BALL
POINT PEN-PRESS FIRMLY,
PRINT CLEARLY.

WATER WELL RECORD
KSA 82a-1201-1215

Kansas Department of Health and
Environment-Division of Environment
(Water well Contractors)
Topeka, Kansas 66620

1. Location of well: County <u>Sumner</u> Fraction <u>NW 1/4 SW 1/4</u> Section number <u>4</u> Township number <u>T 30 S</u> Range number <u>R 4 E</u>																						
2. Distance and direction from nearest town or city: <u>1/2 mile S.W. Viola Ks</u> Street address of well location if in city: <u>2 miles No Milton K-42 Hwy</u>																						
3. Owner of well: <u>Hugh Bastic</u> R.R. or street: <u>Box 56</u> City, state, zip code: <u>Milton Ks 67106</u>																						
4. Locate with "X" in section below: Sketch map: 																						
5. Type and color of material																						
<table border="1"><thead><tr><th></th><th>From</th><th>To</th></tr></thead><tbody><tr><td>Top soil</td><td>0</td><td>2</td></tr><tr><td>Red. clay.</td><td>2</td><td>12</td></tr><tr><td>med. gravel.</td><td>12</td><td>20</td></tr><tr><td>gray clay.</td><td>20</td><td>28</td></tr><tr><td>med. to fine sand.</td><td>28</td><td>39</td></tr><tr><td>red shale -</td><td>39</td><td>51</td></tr>
6. Bore hole dia. <u>5 1/2</u> in. Completion date <u>9/28/78</u> Well depth <u>51</u> ft.																						
7. Cable tool <input checked="" type="checkbox"/> Rotary <input type="checkbox"/> Driven <input type="checkbox"/> Dug Hollow rod <input type="checkbox"/> Jetted <input type="checkbox"/> Bored <input type="checkbox"/> Reverse rotary																						
8. Use: <input checked="" type="checkbox"/> Domestic <input type="checkbox"/> Public supply <input type="checkbox"/> Industry <input type="checkbox"/> Irrigation <input type="checkbox"/> Air conditioning <input type="checkbox"/> Stock <input type="checkbox"/> Law <input type="checkbox"/> Oil field water <input type="checkbox"/> Other																						
9. Casing: Material <u>Steel</u> Height Above or below Threaded <input checked="" type="checkbox"/> Welded <input checked="" type="checkbox"/> Surface <u>12</u> in. RMP <input checked="" type="checkbox"/> PVC <input type="checkbox"/> Weight <u>150</u> lbs./ft. Dia. <u>5 1/2</u> in. to <u>5 1/2</u> ft. depth Wall Thickness: inches or Dia. <u>5 1/2</u> in. to <u>5 1/2</u> ft. depth gage No. <u>200</u>																						
10. Screen: Manufacturer's name <u>Sunflower</u> Type <u>200</u> Dia. <u>5 1/2</u> Gauge <u>1 1/2</u> Length <u>6 1/2</u> ft. Set between <u>4 1/2</u> ft. and <u>6 1/2</u> ft. Gravel pack <u>yes</u> size range of material <u>3/8</u>																						
11. Static water level: <u>25</u> ft. below land surface Date <u>9/28/78</u>																						
12. Pumping level below land surfaces: <u>33</u> ft. after <u>1/2</u> hrs. pumping <u>10</u> g.p.m. <u> </u> ft. after <u> </u> hrs. pumping <u> </u> g.p.m. Estimated maximum yield <u>15-25</u> g.p.m.																						
13. Water sample submitted: <u> </u> mo./day/yr. <input type="checkbox"/> Yes <input checked="" type="checkbox"/> No Date <u> </u>																						
14. Well head completion: <input type="checkbox"/> Pitless adapter <u>12</u> inches above grade																						
15. Well grouted? <u>yes</u> With: <input checked="" type="checkbox"/> Neat cement <input type="checkbox"/> Bentonite <input checked="" type="checkbox"/> Concrete Depth: From <u>3</u> ft. to <u>13</u> ft.																						
16. Nearest source of possible contamination: ft. <u>100</u> Direction <u>E</u> Type <u>Septic</u> Well disinfected upon completion? <input checked="" type="checkbox"/> Yes <input type="checkbox"/> No																						
17. Pump: <input checked="" type="checkbox"/> Not installed Manufacturer's name <u> </u> Model number <u> </u> HP <u> </u> Volts <u> </u> Length of drop pipe <u> </u> ft. capacity <u> </u> g.p.m. Type: <input type="checkbox"/> Submersible <input type="checkbox"/> Turbine <input type="checkbox"/> Jet <input type="checkbox"/> Reciprocating <input type="checkbox"/> Centrifugal <input type="checkbox"/> Other																						
18. Elevation: <u> </u> Topography: <input checked="" type="checkbox"/> Hill <input type="checkbox"/> Slope <input type="checkbox"/> Upland <input type="checkbox"/> Valley																						
19. Remarks: <u>Customer to furnish 4'x4'x4" slab around casing per State Regulations</u> <u>Signed X Hugh Bastic</u>																						
20. Water well contractor's certification: This well was drilled under my inspection and this report is true to the best of my knowledge and belief. <u>Weninger Bulfinch 318</u> Business name <u>Colwich</u> License No. <u> </u> Address <u> </u> Signature <u>Weninger</u> Date <u>9/28/78</u> Authorized representative																						

Forward the white, blue and pink copies to the Department of Health and Environment

Form WWC-5