


1 LOCATION OF WATER WELL: Sumner	FRACTION NW 1/4 SW 1/4 SW 1/4	Section Number 4	Township Number T 30 S	Range Number R 4W E/W
--	---	----------------------------	----------------------------------	---------------------------------

Distance and direction from nearest town or city street address of well if located within city?
3/8 N., 1/8 E. of K-42 & Suppesville, Ks.

2 WATER WELL OWNER: SCOTT, Tom RR#, ST. ADDRESS, BOX #: R.R. #1 CITY, STATE, ZIP CODE: Milton, Kansas	Board of Agriculture, Division of Water Resource Application Number:
--	---

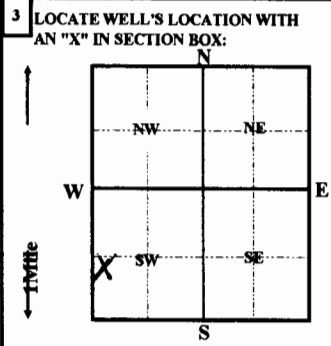

4 DEPTH OF COMPLETED WELL 127 ft. ELEVATION: Depth(s) groundwater Encountered 1 ft. 2 ft. 3 ft.	WELL'S STATIC WATER LEVEL 15 FT. BELOW LAND SURFACE MEASURED ON 07/28/1992 mo/day/yr
Pump test data: Well water was _____ ft. after _____ hours pumping _____ gpm	
Est. Yield _____ gpm: Well water was _____ ft. after _____ hours pumping _____ gpm	
Bore Hole Diameter 12 in. to 127 ft., and _____ in. to _____ ft.	
WELL WATER TO BE USED AS: 5 Public water supply 8 Air conditioning 11 Injection well	
1 Domestic 3 Feedlot 6 Oil field water supply 9 Dewatering 12 Other (Specify below)	
2 Irrigation 4 Industrial 7 Lawn and garden only 10 Monitoring well	
Was a chemical/bacteriological sample submitted to Department? Yes _____ No X ; If yes, mo/day/yr sample was submitted _____	
Water Well Disinfected? Yes X No _____	

5 TYPE OF CASING USED: 1 Steel 3 RMP (SR) 2 PVC 4 ABS	5 Wrought iron 8 Concrete tile 6 Asbestos-Cement 9 Other (Specify below) 7 Fiberglass SDR-26	CASING JOINTS: Glued X Clamped Welded Threaded
Blank casing Diameter 5 in. to 22 ft., Dia _____ in. to _____ ft.		
Casing height above land surface 12 in., weight 2.35 lbs. / ft. Wall thickness or gauge No. .214		
TYPE OF SCREEN OR PERFORATION MATERIAL: 1 Steel 3 Stainless Steel 5 Fiberglass 8 RMP (SR) 11 other (specify) 2 Brass 4 Galvanized steel 6 Concrete tile 9 ABS 12 None used (open hole)		
SCREEN OR PERFORATION OPENING ARE: 1 Continuous slot 3 Mill slot 5 Gauzed wrapped 8 Saw cut 11 None (open hole) 2 Louvered shutter 4 Key punched 6 Wire wrapped 9 Drilled holes 7 Torch cut 10 Other (specify)		
SCREEN-PERFORATION INTERVALS: from 22 ft. to 127 ft., From _____ ft. to _____ ft.		
GRAVEL PACK INTERVALS: from 21 ft. to 127 ft., From _____ ft. to _____ ft.		

6 GROUT MATERIAL: 1 Neat cement	2 Cement grout	3 Bentonite	4 Other
Grout Intervals: From 4 ft. to 21 ft., From _____ ft. to _____ ft.			
What is the nearest source of possible contamination: 1 Septic tank 4 Lateral lines 7 Pit privy 10 Livestock pens 14 Abandon water well 2 Sewer lines 5 Cess pool 8 Sewage lagoon 11 Fuel storage 15 Oil well/Gas well 3 Watertight sewer lines 6 Seepage pit 9 Feedyard 12 Fertilizer storage 16 Other (specify below) 13 Insecticide storage			
Direction from well? North		How many feet? 55	

FROM	TO	LITHOLOGIC LOG	FROM	TO	PLUGGING INTERVALS
0	3	topsoil			
3	6	fine sand			
6	23	clay			
23	24	fine sand			
24	127	red shale			
					<div style="font-size: 2em; font-weight: bold; margin-bottom: 10px;">RECEIVED</div> <div style="font-size: 1.2em; margin-bottom: 10px;">MAY 07 1993</div> <div style="font-size: 1.2em;">BUREAU OF WATER</div>

7 CONTRACTOR'S OR LANDOWNER'S CERTIFICATION: This water well was (1) constructed, (2) reconstructed, or (3) plugged under my jurisdiction and was completed on (mo/day/year) 07/28/1992 and this record is true to the best of my knowledge and belief. Kansas Water Well Contractor's License No. 236 This Water Well Record was completed on (mo/day/yr) 04/06/93 Under the business name of Harp Well & Pump Service, Inc. by (signature) <i>Jane Grederrick</i>	319
--	------------