

1 LOCATION OF WATER WELL:	Fraction SW ¼ SW ¼ NW ¼	Section Number 4	Township Number T 30 S	Range Number R 4 E
---------------------------	---	----------------------------	----------------------------------	------------------------------

Distance and direction from nearest town or city street address of well if located within city?

1 N Suppesville


2 WATER WELL OWNER: Wayne Schwartz
RR#, St. Address, Box #: Spivey. ks. 67142
City, State, ZIP Code :

Board of Agriculture, Division of Water Resources
Application Number:

3 LOCATE WELL'S LOCATION WITH AN "X" IN SECTION BOX:

4 DEPTH OF COMPLETED WELL 50 ft. ELEVATION:
 Depth(s) Groundwater Encountered 1. 23 ft. 2. ft. 3. 8-19-93 ft.
 WELL'S STATIC WATER LEVEL 19 ft. below land surface measured on mo/day/yr

	N	
I	I	I

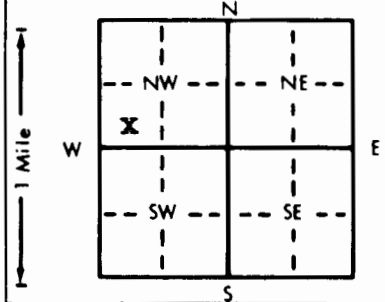

Pump test data: Well water was ft. after hours pumping gpm
Est. Yield ... 12 ... gpm: Well water was ft. after hours pumping gpm
Bore Hole Diameter ... 9 ... in. to 50 ... ft., and in. to ft.

WELL WATER TO BE USED AS:

	5 Public water supply	8 Air conditioning	11 Injection well
<u>1 Domestic</u>	3 Feedlot	6 Oil field water supply	9 Dewatering
2 Irrigation	4 Industrial	7 Lawn and garden only	10 Monitoring well
			12 Other (Specify below)

Was a chemical/bacteriological sample submitted to Department? Yes.....No.....; If yes, mo/day/yr sample was submitted

Water Well Disinfected? Yes No

5	TYPE OF BLANK CASING USED:
---	----------------------------

5 Wrought iron 8 Concrete tile CASING JOINTS: Glued Clamped

1 Steel 3 RMP (SR) 6 Asbestos-Cement 9 Other (specify below) Welded
2 PVC 4 ABS 7 Fiberglass Threaded
Blank casing diameter 5 in. to 31 ft., Dia. in. to ft., Dia. in. to ft.
Casing height above land surface 17 in., weight lbs./ft. Wall thickness or gauge No. 210

TYPE OF SCREEN OR PERFORATION MATERIAL:

1 Steel	3 Stainless steel	5 Fiberglass	8 RMP (SR)	11 Other (specify)
2 Brass	4 Galvanized steel	6 Concrete tile	9 ABS	12 None used (open hole)

SCREEN OR PERFORATION OPENINGS ARE:

1 Continuous slot	3 Mill slot	6 Wire wrapped	<u>9 Drilled holes</u>
2 Louvered shutter	4 Key punched	7 Torch cut	10 Other (specify)

SCREEN-PERFORATED INTERVALS: From 31 ft. to 41 ft. From _____ ft. to _____ ft.

GRAVEL PACK INTERVALS: From 23 ft. to 50 ft. From . ft. to . ft.

6 GROUT MATERIAL: 1 Neat cement 2 Cement grout 3 Bentonite 4 Other
Grout Intervals: From 3 ft. to 23 ft. From ft. to ft. From ft. to ft.

What is the nearest source of possible contamination:

1 Septic tank	4 Lateral lines	7 Pit privy	11 Fuel storage	15 Oil well/Gas well
2 <u>Sewer lines</u>	5 Cess pool	8 Sewage lagoon	12 Fertilizer storage	16 Other (specify below)
3 Watertight sewer lines	6 Seepage pit	9 Feedyard	13 Insecticide storage	100

Direction from well?	East
----------------------	------

How many feet?

[illegible]

7 CONTRACTOR'S OR LANDOWNER'S CERTIFICATION: This water well was (1) constructed, (2) reconstructed, or (3) plugged under my jurisdiction and was completed on (mo/day/year) 140 8-19-93 and this record is true to the best of my knowledge and belief. Kansas Water Well Contractor's License No. 140 This Water Well Record was completed on (mo/day/yr) 8-5-93 under the business name of Lvan Inc. by (signature) [Signature]

INSTRUCTIONS: Use typewriter or ball point pen. PLEASE PRESS FIRMLY and PRINT clearly. Please fill in blanks, underline or circle the correct answers. Send top three copies to Kansas Department of Health and Environment, Bureau of Water, Topeka, Kansas 66620-0001. Telephone: 913-296-5545. Send one to WATER WELL OWNER and retain one for your records.