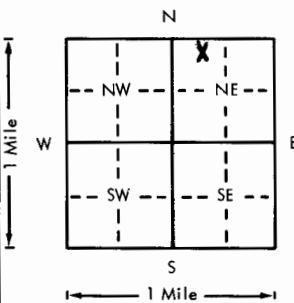


USE TYPEWRITER OR BALL
POINT PEN-PRESS FIRMLY,
PRINT CLEARLY.

WATER WELL RECORD
KSA 82a-1201-1215

Kansas Department of Health and
Environment-Division of Environment
(Water well Contractors)
Topeka, Kansas 66620

Billed To: **Emmit Haynes**

| | | | | | | |
|---|--|-------------------------|--|---|----------------------------------|---------------------------------|
| 1. Location of well: | | County Sumner | Fraction 1/4 NW 1/4 NE 1/4 | Section number 8 | Township number T 30 S | Range number R 4W E/W |
| 2. Distance and direction from nearest town or city: Street address of well location if in city: 1/8 South of K-42 Highway Suppesville, Ks. | | | 3. Owner of well: Ron Tarlton Suppesville, Kansas R.R. or street: City, state, zip code: | | | |
| 4. Locate with "X" in section below: Sketch map:  | | | 6. Bore hole dia. 11 in. Completion date _____ Well depth 80 ft. 6-9-77 | | | |
| 5. Type and color of material | | | 7. <input checked="" type="checkbox"/> Cable tool <input checked="" type="checkbox"/> Rotary <input type="checkbox"/> Driven <input type="checkbox"/> Dug <input type="checkbox"/> Hollow rod <input type="checkbox"/> Jetted <input type="checkbox"/> Bored <input type="checkbox"/> Reverse rotary | | | |
| | | | 8. Use: <input checked="" type="checkbox"/> Domestic <input type="checkbox"/> Public supply <input type="checkbox"/> Industry <input type="checkbox"/> Irrigation <input type="checkbox"/> Air conditioning <input type="checkbox"/> Stock <input type="checkbox"/> Lawn <input type="checkbox"/> Oil field water <input type="checkbox"/> Other | | | |
| | | | 9. Casing: Material Styrene Height: Above or below _____ Threaded <input type="checkbox"/> Welded <input checked="" type="checkbox"/> Surface 12 in. RMP <input checked="" type="checkbox"/> PVC <input type="checkbox"/> Weight _____ lbs./ft. Dia. 5 in. to 80 ft. depth Wall Thickness: inches or Dia. _____ in. to _____ ft. depth Gauge No. 200 | | | |
| | | | 10. Screen: Manufacturer's name _____ Sunflower Plastic Type Styrene Dia. 5" Slot 1/16 in. Length 30' Set between 50 ft. and 80 ft. Gravel pack? yes Size range of material 1/4-1/8" | | | |
| | | | 11. Static water level: _____ mo./day/yr. 25 ft. below land surface Date 6-9-77 | | | |
| | | | 12. Pumping level below land surfaces: _____ ft. after _____ hrs. pumping _____ g.p.m. _____ ft. after _____ hrs. pumping _____ g.p.m. Estimated maximum yield _____ g.p.m. | | | |
| | | | 13. Water sample submitted: _____ mo./day/yr. <input type="checkbox"/> Yes <input type="checkbox"/> No Date _____ | | | |
| | | | 14. Well head completion: <input checked="" type="checkbox"/> Pitless adapter 12 inches above grade | | | |
| | | | 15. Well grouted? yes 1 to 2 fine sand mix. With: <input type="checkbox"/> Neat cement <input type="checkbox"/> Bentonite <input checked="" type="checkbox"/> Concrete Depth: From 40' ft. to 14 ft. | | | |
| | | | 16. Nearest source of possible contamination: ft. 75 Direction East Type Septic Tank Well disinfected upon completion? <input checked="" type="checkbox"/> Yes <input type="checkbox"/> No | | | |
| | | | 17. Pump: Manufacturer's name Sta-Rite Not installed Model number 20P4D02 HP 3/4 Volts 230 Length of drop pipe 70 ft. capacity 20 g.p.m. Type: <input checked="" type="checkbox"/> Submersible <input type="checkbox"/> Turbine <input type="checkbox"/> Jet <input type="checkbox"/> Reciprocating <input type="checkbox"/> Centrifugal <input type="checkbox"/> Other | | | |
| | | | (Use a second sheet if needed) | | | |
| 18. Elevation: Topography: <input type="checkbox"/> Hill <input checked="" type="checkbox"/> Slope <input type="checkbox"/> Upland <input type="checkbox"/> Valley | | 19. Remarks: | | 20. Water well contractor's certification: This well was drilled under my jurisdiction and this report is true to the best of my knowledge and belief. Harp Well & Pump 236 Business name License No. Address Wichita, Kansas Signed M. Arnold Date 6-15-77 Authorized representative | | |

Forward the white, blue and pink copies to the Department of Health and Environment

Form WWC-5