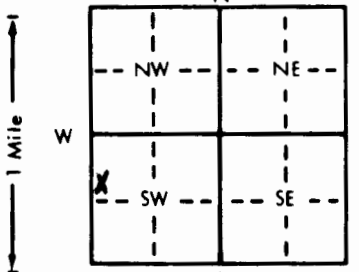


1 LOCATION OF WATER WELL: County: <u>Sumner</u>		Fraction <u>SW</u> $\frac{1}{4}$ <u>NW</u> $\frac{1}{4}$ <u>SW</u> $\frac{1}{4}$		Section Number <u>12</u>	Township Number <u>T 30</u> <u>S</u>	Range Number <u>R 4W</u> <u>E/W</u>
Distance and direction from nearest town or city street address of well if located within city? <u>4 miles E. of K-42 and Viola Rd., then 3/4 mile S. K-42 Viola, Ks.</u>						
2 WATER WELL OWNER: <u>Hart, Chuck</u> RR#, St. Address, Box # : <u>11222 W. 13th Ct.</u> City, State, ZIP Code : <u>Wichita, Ks.</u> Board of Agriculture, Division of Water Resources Application Number:						
chemical/bacteriological sample submitted to Department? Yes <u>No</u> <u>X</u> ; If yes, mo/day/yr sample was submitted <u>X</u> No Water Well Disinfected? Yes <u>X</u> No				
5 TYPE OF BLANK CASING USED: 1 Steel 3 RMP (SR) 5 Wrought iron 8 Concrete tile CASING JOINTS: Glued <u>X</u> Clamped 2 PVC 4 ABS 6 Asbestos-Cement 9 Other (specify below) Welded 7 Fiberglass SDR-26 Threaded Blank casing diameter <u>5</u> in. (open hole) SCREEN OR PERFORATION OPENINGS ARE: 5 Gauzed wrapped 8 Saw cut 11 None (open hole) 1 Continuous slot 3 Mill slot 6 Wire wrapped 9 Drilled holes 2 Louvered shutter 4 Key punched 7 Torch cut 10 Other (specify) SCREEN-PERFORATED INTERVALS: From <u>25</u> ft. to <u>60</u> ft. From <u>25</u> ft. to <u>60</u> ft. GRAVEL PACK INTERVALS: From <u>24</u> ft. to <u>60</u> ft. From <u>24</u> ft. to <u>60</u> ft.						
6 GROUT MATERIAL: 1 Neat cement 2 Cement grout 3 Bentonite 4 Other Grout Intervals: From <u>4</u> ft. to <u>24</u> ft. From <u>24</u> ft. to <u>24</u> ft. From <u>24</u> ft. to <u>24</u> ft. What is the nearest source of possible contamination: 1 Septic tank 4 Lateral lines 7 Pit privy 11 Livestock pens 14 Abandoned water well 2 Sewer lines 5 Cess pool 8 Sewage lagoon 12 Fuel storage 15 Oil well/Gas well 3 Watertight sewer lines 6 Seepage pit 9 Feedyard 13 Insecticide storage 16 Other (specify below) Direction from well? <u>None Apparent</u> How many feet? FROM TO LITHOLOGIC LOG FROM TO PLUGGING INTERVALS 0 3 topsoil 3 14 clay 14 19 fine sand 19 60 red shale						
7 CONTRACTOR'S OR LANDOWNER'S CERTIFICATION: This water well was (1) constructed, (2) reconstructed, or (3) plugged under my jurisdiction and was completed on (mo/day/year) <u>11-28-90</u> and this record is true to the best of my knowledge and belief. Kansas Water Well Contractor's License No. <u>236</u> This Water Well Record was completed on (mo/day/yr) <u>3-30-91</u> under the business name of <u>Harp Well and Pump Service, Inc.</u> by (signature) <u>Mary Arnold</u>						
INSTRUCTIONS: Use typewriter or ball point pen. PLEASE PRESS FIRMLY and PRINT clearly. Please fill in blanks, underline or circle the correct answers. Send top three copies to Kansas Department of Health and Environment, Bureau of Water, Topeka, Kansas 66620-7320. Telephone: 913-296-5545. Send one to WATER WELL OWNER and retain one for your records.						