WATER WELL RECORD Form WWC-5 KSA 82a-1212

1 LOCATION OF WATER WELL: County: Sumner | Fraction: Near Center of ¼ ¼ NW ¼ | Section Number: 17 | Township Number: T 30 S | Range Number: R 4 E/W

Distance and direction from nearest town or city? ½ mile north-west of Milton, KS | Street address of well if located within city?

2 WATER WELL OWNER: A.J. Fieser
RR#, St. Address, Box # :
City, State, ZIP Code : Milton, KS 67106
Board of Agriculture, Division of Water Resources Application Number: Not available

3 DEPTH OF COMPLETED WELL XX 82 ft. Bore Hole Diameter 24 in. to 82 ft., and ..... in. to ..... ft.

Well Water to be used as: 1 Domestic 2 Irrigation 3 Feedlot 4 Industrial 5 Public water supply 6 Oil field water supply 7 Lawn and garden only 8 Air conditioning 9 Dewatering 10 Observation well 11 Injection well 12 Other (Specify below) .....

Well's static water level 13 ft. below land surface measured on 11 month 11 day 1980 year

Pump Test Data: Well water was 17 ft. after one hours pumping 400 to 1100 gpm
Est. Yield 1100 gpm: Well water was ft. after hours pumping gpm

4 TYPE OF BLANK CASING USED: 1 Steel 2 PVC 3 RMP (SR) 4 ABS 5 Wrought iron 6 Asbestos-Cement 7 Fiberglass 8 Concrete tile 9 Other (specify below) .....
Casing Joints: Glued ..... Clamped ..... Welded XX Threaded .....

Blank casing dia 16 in. to 42 ft., Dia ..... in. to ..... ft., Dia ..... in. to ..... ft.
Casing height above land surface 12 in., weight 31.75 lbs./ft. Wall thickness or gauge No 7 ga.

TYPE OF SCREEN OR PERFORATION MATERIAL: 1 Steel 2 Brass 3 Stainless steel 4 Galvanized steel 5 Fiberglass 6 Concrete tile 7 PVC 8 RMP (SR) 9 ABS 10 Asbestos-cement 11 Other (specify) ..... 12 None used (open hole)

Screen or Perforation Openings Are: 1 Continuous slot 2 Louvered shutter 3 Mill slot 4 Key punched 5 Gauzed wrapped 6 Wire wrapped 7 Torch cut 8 Saw cut 9 Drilled holes 10 Other (specify) Doerr Bridge Slot 11 None (open hole)

Screen-Perforation Dia 16 in. to 82 ft., Dia ..... in. to ..... ft., Dia ..... in to ..... ft.
Screen-Perforated Intervals: From 42 ft. to 82 ft., From ..... ft. to ..... ft.
From ..... ft. to ..... ft., From ..... ft. to ..... ft.
Gravel Pack Intervals: From 10 ft. to 82 ft., From ..... ft. to ..... ft.
From ..... ft. to ..... ft., From ..... ft. to ..... ft.

5 GROUT MATERIAL: 1 Neat cement 2 Cement grout 3 Bentonite 4 Other .....
Grouted Intervals: From 0 ft. to 10 ft., From ..... ft. to ..... ft., From ..... ft. to ..... ft.

What is the nearest source of possible contamination: 1 Septic tank 2 Sewer lines 3 Lateral lines 4 Cess pool 5 Seepage pit 6 Pit privy 7 Sewage lagoon 8 Feed yard 9 Livestock pens 10 Fuel storage 11 Fertilizer storage 12 Insecticide storage 13 Watertight sewer lines 14 Abandoned water well 15 Oil well/Gas well 16 Other (specify below) Field
Direction from well n/a How many feet n/a ? Water Well Disinfected? Yes ..... No x
Was a chemical/bacteriological sample submitted to Department? Yes ..... No x If yes, date sample was submitted ..... month ..... day ..... year: Pump Installed? Yes x No .....
If Yes: Pump Manufacturer's name Peerless Pump Co. Model No. 12MB-3 HP 40 Volts 460
Depth of Pump Intake 70 ft. Pumps Capacity rated at 750 gal./min.
Type of pump: 1 Submersible 2 Turbine 3 Jet 4 Centrifugal 5 Reciprocating 6 Other

6 CONTRACTOR'S OR LANDOWNER'S CERTIFICATION: This water well was (1) constructed, (2) reconstructed, or (3) plugged under my jurisdiction and was completed on 11 month 11 day 1980 year and this record is true to the best of my knowledge and belief. Kansas Water Well Contractor's License No. 185
This Water Well Record was completed on 1 month 26 day 1981 year under the business name of Clarke Well & Eq., Inc. by (signature) D W Clarke

7 LOCATE WELL'S LOCATION WITH AN "X" IN SECTION BOX:

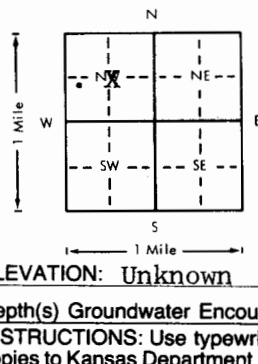

ELEVATION: Unknown

FROM	TO	LITHOLOGIC LOG	FROM	TO	LITHOLOGIC LOG
0	2	Topsoil	48	49	Tan clay
2	4	Sand & gravel, fine & med	49	54	Fine sand & gravel
4	5	Gray & brn clay,fine sand	54	56	Soft cemented sand
5	9	V.fine & fine sand & grvl	56	62	V.fine to fine sand & grvl
9	28	Fine & Med. sand & gravel	62	70	Red shale,hard tan clay
		with tan clay streak	70	74	V.fine sand & gravel
28	29	V.Fine sand & gravel	74	77	Streak of shale & clay
29	40	Tan clay	77	80	Very fine sand & gravel
40	43	V.fine to fine sand & gravel	80	81	Red shale
43	48	V.fine sand & grvl w/tan clay streaks			

Depth(s) Groundwater Encountered 1 13 ft. 2 ..... ft. 3 ..... ft. 4 ..... ft. (Use a second sheet if needed)

INSTRUCTIONS: Use typewriter or ball point pen, *please press firmly* and *PRINT* clearly. Please fill in blanks, underline or circle the correct answers. Send top three copies to Kansas Department of Health and Environment, Division of Environment, Water Well Contractors, Topeka, KS 66620. Send one to WATER WELL OWNER and retain one for your records.

OFFICE USE ONLY
T 30
R 4 E
SEC. 17
¼ ¼ ¼