


1 LOCATION OF WATER WELL:	Fraction	Section Number	Township Number	Range Number
County: <u>Sumner</u>	<u>SW 1/4 SE 1/4 SE 1/4</u>	<u>17</u>	T <u>30</u> S	R <u>4</u> E

Distance and direction from nearest town or city street address of well if located within city?

Milton KS

2 WATER WELL OWNER:	Board of Agriculture, Division of Water Resources
RR#, St. Address, Box # :	Application Number:
City, State, ZIP Code :	

3 LOCATE WELL'S LOCATION WITH AN "X" IN SECTION BOX:	4 DEPTH OF COMPLETED WELL: <u>81</u> ft. ELEVATION:
--	---

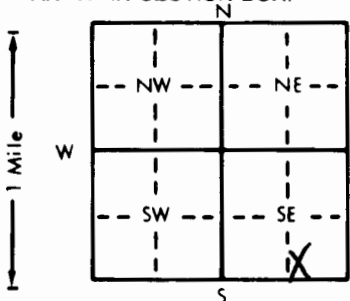

Depth(s) Groundwater Encountered 1. ft. 2. ft. 3. ft.

WELL'S STATIC WATER LEVEL 20 ft. below land surface measured on mo/day/yr 8-12-92

Pump test data: Well water was ft. after hours pumping gpm

Est. Yield gpm: Well water was ft. after hours pumping gpm

Bore Hole Diameter in. to ft., and in. to ft.

WELL WATER TO BE USED AS:

1 Domestic	3 Feedlot	6 Oil field water supply	9 Dewatering	12 Other (Specify below)
2 Irrigation	4 Industrial	7 Lawn and garden only	10 Monitoring well	

Was a chemical/bacteriological sample submitted to Department? Yes No X; If yes, mo/day/yr sample was sub-mitted Water Well Disinfected? Yes X No

5 TYPE OF BLANK CASING USED:	5 Wrought iron	8 Concrete tile	CASING JOINTS: Glued <u>X</u> Clamped
------------------------------	----------------	-----------------	---------------------------------------

1 Steel	3 RMP (SR)	6 Asbestos-Cement	9 Other (specify below)	Welded
2 PVC	4 ABS	7 Fiberglass		Threaded

Blank casing diameter 5 in. to 61 ft. Dia. in. to ft. Dia. in. to ft.Casing height above land surface 12 in. weight 2.60 lbs./ft. Wall thickness or gauge No. 160PVC

TYPE OF SCREEN OR PERFORATION MATERIAL:

1 Steel	3 Stainless steel	5 Fiberglass	8 RMP (SR)	10 Asbestos-cement
2 Brass	4 Galvanized steel	6 Concrete tile	9 ABS	11 Other (specify)
				12 None used (open hole)

SCREEN OR PERFORATION OPENINGS ARE:

1 Continuous slot	3 Mill slot	5 Gauzed wrapped	8 Saw cut	11 None (open hole)
2 Louvered shutter	4 Key punched	6 Wire wrapped	9 Drilled holes	
		7 Torch cut	10 Other (specify)	

SCREEN-PERFORATED INTERVALS: From 61 ft. to 81 ft. From ft. to ft. From ft. to ft. From ft. to ft.GRAVEL PACK INTERVALS: From 20 ft. to 81 ft. From ft. to ft. From ft. to ft. From ft. to ft.

GROUT MATERIAL:

1 Neat cement	2 Cement grout	3 Bentonite	4 Other
---------------	----------------	-------------	---------

Grout Intervals: From 3 ft. to 20 ft. From ft. to ft. From ft. to ft. From ft. to ft.

What is the nearest source of possible contamination:

1 Septic tank	4 Lateral lines	7 Pit privy	10 Livestock pens	14 Abandoned water well
2 Sewer lines	5 Cess pool	8 Sewage lagoon	11 Fuel storage	15 Oil well/Gas well
3 Watertight sewer lines	6 Seepage pit	9 Feedyard	12 Fertilizer storage	16 Other (specify below)
			13 Insecticide storage	

Direction from well? South How many feet? 85

FROM TO LITHOLOGIC LOG FROM TO PLUGGING INTERVALS

0	2	top soil			
2	10	clay			
10	30	fine sand			
30	32	clay			
32	60	fine sand			
60	63	clay			
63	80	med sand			
80	81	shale			

7 CONTRACTOR'S OR LANDOWNER'S CERTIFICATION: This water well was (1) constructed, (2) reconstructed, or (3) plugged under my jurisdiction and was

completed on (mo/day/year) 8-12-92 and this record is true to the best of my knowledge and belief. KansasWater Well Contractor's License No. 318 This Water Well Record was completed on (mo/day/yr) 8-14-92under the business name of Weninger Drilling Inc by (signature) Susan Weninger