


**WATER WELL RECORD Form WWC-5 KSA 82a-1212**

1 LOCATION OF WATER WELL: County: <u>Stanton</u>	Fraction <u>NE 1/4 NE 1/4 NE 1/4</u>	Section Number <u>12</u>	Township Number <u>T 30 S</u>	Range Number <u>R 40</u> <span style="float:right;">E/W</span>
---	---	-----------------------------	----------------------------------	---

Distance and direction from nearest town or city street address of well if located within city?  
7 miles south 4 west of Big Bow, Kansas

2 WATER WELL OWNER: Seaboard Farms, Inc. Well # 1 on farm #10  
 RR#, St. Address, Box # : P. O. Box 1029 Board of Agriculture, Division of Water Resources  
 City, State, ZIP Code : Hugoton, Kansas 67951 Application Number:

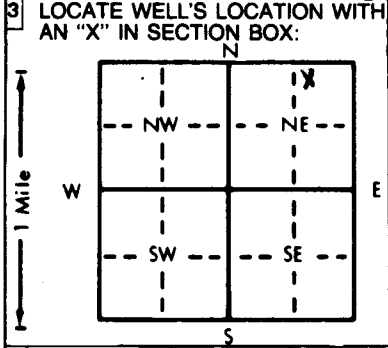

4 DEPTH OF COMPLETED WELL: 4.03 ft. ELEVATION: slope

Depth(s) Groundwater Encountered 1. 2.65 ft. 2. \_\_\_\_\_ ft. 3. \_\_\_\_\_ ft.

WELL'S STATIC WATER LEVEL 2.65 ~~2.65~~ below land surface measured on mo/day/yr 5/8/95

Pump test data: Well water was \_\_\_\_\_ ft. after \_\_\_\_\_ hours pumping \_\_\_\_\_ gpm

Est. Yield \_\_\_\_\_ gpm: Well water was did not start pumping after \_\_\_\_\_ hours pumping \_\_\_\_\_ gpm

Bore Hole Diameter... 9.7/8 to 4.03 ft., and \_\_\_\_\_ in. to \_\_\_\_\_ ft.

WELL WATER TO BE USED AS: 5 Public water supply 8 Air conditioning 11 Injection well  
 1 Domestic 3 Feedlot 6 Oil field water supply 9 Dewatering 12 Other (Specify below)  
 2 Irrigation 4 Industrial 7 Lawn and garden only 10 Monitoring well stock

Was a chemical/bacteriological sample submitted to Department? Yes \_\_\_\_\_ No X; If yes, mo/day/yr sample was submitted \_\_\_\_\_

Water Well Disinfected? Yes X No

5 TYPE OF CASING USED:

1 Steel	3 RMP (SR)	6 Asbestos-Cement	9 Other (specify below)	CASING JOINTS: Glued <u>X</u> Clamped _____
<u>2 PVC</u>	4 ABS	7 Fiberglass		and riveted _____
				Threaded _____

Blank casing diameter 5 in. to 3.23 ft., Dia 5 in. to 3.83 ft., Dia \_\_\_\_\_ in. to \_\_\_\_\_ ft.

Casing height above land surface 18 in., weight schedule 200 PVC lbs./ft. Wall thickness or gauge No. \_\_\_\_\_

TYPE OF SCREEN OR PERFORATION MATERIAL:

1 Steel	3 Stainless steel	5 Fiberglass	<u>7 PVC</u>	10 Asbestos-cement
2 Brass	4 Galvanized steel	6 Concrete tile	8 RMP (SR)	11 Other (specify) _____
			9 ABS	12 None used (open hole)

SCREEN OR PERFORATION OPENINGS ARE:

1 Continuous slot	<u>3 Mill slot</u>	5 Gauzed wrapped	8 Saw cut	11 None (open hole)
2 Louvered shutter	4 Key punched	6 Wire wrapped	9 Drilled holes	
		7 Torch cut	10 Other (specify) _____	

SCREEN-PERFORATED INTERVALS: From 3.23 ft. to 3.63 ft., From \_\_\_\_\_ ft. to \_\_\_\_\_ ft.

From 3.83 ft. to 4.03 ft., From \_\_\_\_\_ ft. to \_\_\_\_\_ ft.

GRAVEL PACK INTERVALS: From 2.4 ft. to 4.03 ft., From \_\_\_\_\_ ft. to \_\_\_\_\_ ft.

From \_\_\_\_\_ ft. to \_\_\_\_\_ ft., From \_\_\_\_\_ ft. to \_\_\_\_\_ ft.

6 GROUT MATERIAL: 1 Neat cement 2 Cement grout 3 Bentonite 4 Other \_\_\_\_\_

Grout Intervals: From 4 ft. to 24 ft., From \_\_\_\_\_ ft. to \_\_\_\_\_ ft., From \_\_\_\_\_ ft. to \_\_\_\_\_ ft.

What is the nearest source of possible contamination:

1 Septic tank	4 Lateral lines	7 Pit privy	10 Livestock pens	14 Abandoned water well
2 Sewer lines	5 Cess pool	8 Sewage lagoon	11 Fuel storage	15 Oil well/Gas well
3 Watertight sewer lines	6 Seepage pit	9 Feedyard	12 Fertilizer storage	16 Other (specify below)
			13 Insecticide storage	<u>None</u>

Direction from well? How many feet?

FROM	TO	LITHOLOGIC LOG	FROM	TO	PLUGGING INTERVALS
0	2	Surface			
2	30	Sandy clay			
30	40	Medium sand			
40	100	Sandy clay w/lime shells			
100	200	Coarse sand w/cemented strips			
200	220	Cemented sand			
220	285	Sandy clay and clay w/sand strips			
285	320	Medium <del>sand</del> to coarse sand w/clay breakers			
320	345	Coarse sand			
345	360	Coarse sand w/cemented strips			
360	380	Sandy clay			
380	403	Medium to coarse sand w/clay breakers			

7 CONTRACTOR'S OR LANDOWNER'S CERTIFICATION: This water well was (1) constructed (2) reconstructed, or (3) plugged under my jurisdiction and was completed on (mo/day/year) 5/18/95 and this record is true to the best of my knowledge and belief. Kansas Water Well Contractor's License No. 164 This Water Well Record was completed on (mo/day/yr) 6/25/95 under the business name of Houck Bros. Drlg.Co. by (signature) M. Beard

INSTRUCTIONS: Use typewriter or ball point pen. PLEASE PRESS FIRMLY and PRINT clearly. Please fill in blanks, underline or circle the correct answers. Send top three copies to Kansas Department of Health and Environment, Bureau of Water, Topeka, Kansas 66620-0001. Telephone: 913-296-5545. Send one to WATER WELL OWNER and retain one for your records.