


1 LOCATION OF WATER WELL: Fraction Section Number Township Number Range Number
 County: Stanton SW 1/4 SW 1/4 SW 1/4 21 T 30 S R 40 EW

Distance and direction from nearest town or city street address of well if located within city?
 10 miles south and 3 east of Johnson, Kansas

2 WATER WELL OWNER: Seaboard Farms, Inc. Shore #2 on the above described
 RR#, St. Address, Box # : P. O. Box 1029 Board of Agriculture, Division of Water Resources
 City, State, ZIP Code : Hugoton, Kansas 67 951 Application Number:

3 LOCATE WELL'S LOCATION WITH AN "X" IN SECTION BOX:

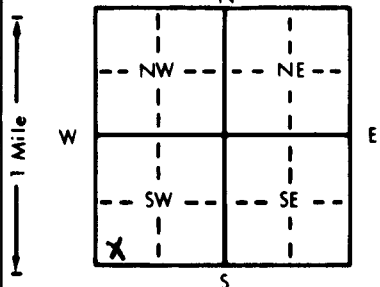

4 DEPTH OF COMPLETED WELL: 276 ft. ELEVATION: slope
 Depth(s) Groundwater Encountered 1. 214 ft. 2. ft. 3. ft.
 WELL'S STATIC WATER LEVEL: 2.14 ft. below land surface measured on mo/day/yr 10/30/95
 Pump test data: Well water was NA ft. after hours pumping gpm
 Est. Yield gpm: Well water was NA ft. after hours pumping gpm
 Bore Hole Diameter: 12 1/2 in. to 276 ft., and in. to ft.
 WELL WATER TO BE USED AS:
 1 Domestic 3 Feedlot 6 Oil field water supply 9 Dewatering 12 Other (Specify below)
 2 Irrigation 4 Industrial 7 Lawn and garden only 10 Monitoring well stock
 Was a chemical/bacteriological sample submitted to Department? Yes No x; If yes, mo/day/yr sample was submitted
 Water Well Disinfected? Yes x No

5 TYPE OF BLANK CASING USED:
 1 Steel 3 RMP (SR) 5 Wrought iron 8 Concrete tile CASING JOINTS: Glued x Clamped x
 2 PVC 4 ABS 6 Asbestos-Cement 9 Other (specify below) Welded
 7 Fiberglass Threaded

Blank casing diameter: 6 in. to 216 ft., Dia. in. to ft., Dia. in. to ft.
 Casing height above land surface: 18 in., weight schedule 200 SDR lbs/ft. Wall thickness or gauge No.

TYPE OF SCREEN OR PERFORATION MATERIAL:
 1 Steel 3 Stainless steel 5 Fiberglass 7 PVC 10 Asbestos-cement
 2 Brass 4 Galvanized steel 6 Concrete tile 8 RMP (SR) 11 Other (specify)
 12 None used (open hole)

SCREEN OR PERFORATION OPENINGS ARE:
 1 Continuous slot 3 Mill slot 5 Gauzed wrapped 8 Saw cut 11 None (open hole)
 2 Louvered shutter 4 Key punched 6 Wire wrapped 9 Drilled holes
 7 Torch cut 10 Other (specify)

SCREEN-PERFORATED INTERVALS: From 216 ft. to 276 ft., From ft. to ft.
 GRAVEL PACK INTERVALS: From 24 ft. to 276 ft., From ft. to ft.

6 GROUT MATERIAL: 1 Neat cement 2 Cement grout 3 Bentonite 4 Other
 Grout Intervals: From 4 ft. to 24 ft., From ft. to ft., From ft. to ft.

What is the nearest source of possible contamination:
 1 Septic tank 4 Lateral lines 7 Pit privy 10 Livestock pens 14 Abandoned water well
 2 Sewer lines 5 Cess pool 8 Sewage lagoon 11 Fuel storage 15 Oil well/Gas well
 3 Watertight sewer lines 6 Seepage pit 9 Feedyard 12 Fertilizer storage 16 Other (specify below)
 13 Insecticide storage None

Direction from well? How many feet?

FROM	TO	LITHOLOGIC LOG	FROM	TO	PLUGGING INTERVALS
0	2	Surface			
2	45	Sandy clay			
45	60	fine sand w/clay			
60	120	Coarse sand w/clay breakers			
120	198	Sandy clay w/fine sand strips			
198	222	Gray and brown clay			
222	246	Coarse sand and gravel			
242	267	Sandborkd and sandstone			
267	275	Blue shale w/small sandstone strips			
275	320	Blue shale			

7 CONTRACTOR'S OR LANDOWNER'S CERTIFICATION: This water well was (1) constructed (2) reconstructed, or (3) plugged under my jurisdiction and was completed on (mo/day/year) 10/30/95 and this record is true to the best of my knowledge and belief. Kansas Water Well Contractor's License No. 164 This Water Well Record was completed on (mo/day/yr) November 7, 1995 under the business name of Houck Bros. Drilling Co. by (signature) M. Beard