


| | | | | |
|---|----------------------------|----------------------------|----------------------------------|---------------------------------|
| 1 LOCATION OF WATER WELL: County: Stanton | Fraction SE ¼ SW ¼ SW ¼ | Section Number 9 | Township Number T 30 S | Range Number R 40 E/W |
|---|----------------------------|----------------------------|----------------------------------|---------------------------------|

Distance and direction from nearest town or city street address of well if located within city?
From Hwy Jct. at Johnson, Kansas 9 miles south, 3 east

2 WATER WELL OWNER: **Seaboard Farms, Inc.** Shore # **1** on the above described
 RR#, St. Address, Box # : **P. O. Box 1029** Board of Agriculture, Division of Water Resources
 City, State, ZIP Code : **Hugoton, Kansas 67951** Application Number:

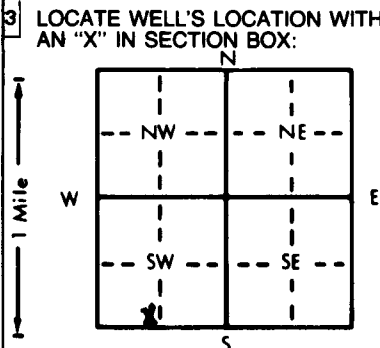

4 DEPTH OF COMPLETED WELL: **298** ft. ELEVATION: **slope**
 Depth(s) Groundwater Encountered 1. **298** ft. 2. _____ ft. 3. _____ ft.
 WELL'S STATIC WATER LEVEL _____ ft. below land surface measured on mo/day/yr
 Pump test data: Well water was _____ ft. after _____ hours pumping _____ gpm
 Est. Yield _____ gpm: Well water was _____ ft. after _____ hours pumping _____ gpm
 Bore Hole Diameter: **14 1/2** in. to **298** in. and _____ in. to _____ ft.
 WELL WATER TO BE USED AS: 5 Public water supply 8 Air conditioning 11 Injection well
 ① Domestic 3 Feedlot 6 Oil field water supply 9 Dewatering 12 Other (Specify below)
 2 Irrigation 4 Industrial 7 Lawn and garden only 10 Monitoring well _____ ST.Q.C.K.
 Was a chemical/bacteriological sample submitted to Department? Yes _____ No ; If yes, mo/day/yr sample was submitted
 Water Well Disinfected? Yes No

5 TYPE OF BLANK CASING USED:
 1 Steel 3 RMP (SR) 5 Wrought iron 8 Concrete tile CASING JOINTS: Glued Clamped
 2 **PVC** 4 ABS 6 Asbestos-Cement 9 Other (specify below) Welded _____
 7 Fiberglass _____ Threaded _____
 Blank casing diameter **8** in. to **250** ft., Dia _____ in. to _____ ft., Dia _____ in. to _____ ft.
 Casing height above land surface **18** in., weight **schedule SDR 21** lbs./ft. Wall thickness or gauge No. _____
 TYPE OF SCREEN OR PERFORATION MATERIAL: 7 **PVC** 10 Asbestos-cement
 1 Steel 3 Stainless steel 5 Fiberglass 8 RMP (SR) 11 Other (specify) _____
 2 Brass 4 Galvanized steel 6 Concrete tile 9 ABS 12 None used (open hole)
 SCREEN OR PERFORATION OPENINGS ARE:
 1 Continuous slot 3 **Mill slot** 5 Gauzed wrapped 8 Saw cut 11 None (open hole)
 2 Louvered shutter 4 Key punched 6 Wire wrapped 9 Drilled holes
 7 Torch cut 10 Other (specify) _____
 SCREEN-PERFORATED INTERVALS: From **250** ft. to **298** ft., From _____ ft. to _____ ft.
 From _____ ft. to _____ ft., From _____ ft. to _____ ft.
 GRAVEL PACK INTERVALS: From **24** ft. to **298** ft., From _____ ft. to _____ ft.
 From _____ ft. to _____ ft., From _____ ft. to _____ ft.

6 GROUT MATERIAL: 1 Neat cement 2 **Cement grout** 3 Bentonite 4 Other _____
 Grout Intervals: From **4** ft. to **24** ft., From _____ ft. to _____ ft., From _____ ft. to _____ ft.
 What is the nearest source of possible contamination:
 1 Septic tank 4 Lateral lines 7 Pit privy 10 Livestock pens 14 Abandoned water well
 2 Sewer lines 5 Cess pool 8 Sewage lagoon 11 Fuel storage 15 Oil well/Gas well
 3 Watertight sewer lines 6 Seepage pit 9 Feedyard 12 Fertilizer storage 16 Other (specify below)
 13 Insecticide storage _____
 Direction from well? How many feet? None

| FROM | TO | LITHOLOGIC LOG | FROM | TO | PLUGGING INTERVALS |
|------|-----|-----------------------------|------|----|--------------------|
| 0 | 2 | Surface | | | |
| 2 | 20 | Brown clay | | | |
| 20 | 80 | Sandy clay and fine sand | | | |
| 80 | 105 | Fine sand w/clay breakers | | | |
| 105 | 160 | Coarse sand | | | |
| 160 | 200 | Fine sand and clay breakers | | | |
| 200 | 240 | Clay w/medium sand strips | | | |
| 240 | 250 | Fine sand | | | |
| 250 | 260 | Sandstone (98%) good | | | |
| 260 | 305 | Sandstone and shale 30% | | | |
| 305 | 320 | Rock | | | |
| 320 | 353 | Blue shale | | | |
| 353 | 387 | Blue shale and sandstone | | | |
| 387 | 430 | Shale and rock very hard | | | |

7 CONTRACTOR'S OR LANDOWNER'S CERTIFICATION: This water well was **(1) constructed**, (2) reconstructed, or (3) plugged under my jurisdiction and was completed on (mo/day/year) **10/12/95** and this record is true to the best of my knowledge and belief. Kansas Water Well Contractor's License No. **164** This Water Well Record was completed on (mo/day/yr) **11-7-95** under the business name of **Houck Bros. drilling Co.** by (signature) **M. Beard**