


1 LOCATION OF WATER WELL: County: Stanton Fraction SW 1/4 SW 1/4 SW 1/4 Section Number 21 Township Number T 30 S Range Number R 40 EW

Distance and direction from nearest town or city street address of well if located within city?
10 miles south 3 east of Johnson, Kansas

2 WATER WELL OWNER: Seaboard Farms, Inc/ Shore #1 on the above described
 RR#, St. Address, Box # : P. O. Box 1029 Board of Agriculture, Division of Water Resources
 City, State, ZIP Code : Hugoton, Kansas 67951 Application Number:

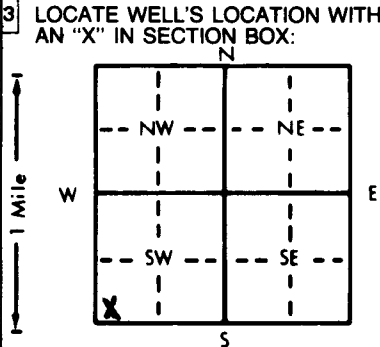

4 DEPTH OF COMPLETED WELL 277 ft. ELEVATION: slope
 Depth(s) Groundwater Encountered 1. 220 ft. 2. _____ ft. 3. _____ ft.
 WELL'S STATIC WATER LEVEL 220 ft. below land surface measured on mo/day/yr 10/24/95
 Pump test data: Well water was _____ after _____ hours pumping _____ gpm
 Est. Yield _____ gpm; Well water was NA after _____ hours pumping _____ gpm
 Bore Hole Diameter 12 1/4 in. to 277 ft., and _____ in. to _____ ft.
 WELL WATER TO BE USED AS:
 1 Domestic 3 Feedlot 6 Oil field water supply 9 Dewatering 12 Other (Specify below)
 2 Irrigation 4 Industrial 7 Lawn and garden only 10 Monitoring well STOCK
 Was a chemical/bacteriological sample submitted to Department? Yes _____ No X; If yes, mo/day/yr sample was submitted
 Water Well Disinfected? Yes X No

5 TYPE OF BLANK CASING USED:
 1 Steel 3 RMP (SR) 5 Wrought iron 8 Concrete tile CASING JOINTS: Glued X Clamped _____
 2 PVC 4 ABS 6 Asbestos-Cement 9 Other (specify below) Welded _____
 Blank casing diameter 6 in. to 227 ft., Dia _____ in. to _____ ft., Dia _____ in. to _____ ft.
 Casing height above land surface 20 in., weight schedule 200 lbs./ft. Wall thickness or gauge No. _____
 TYPE OF SCREEN OR PERFORATION MATERIAL:
 1 Steel 3 Stainless steel 5 Fiberglass 7 PVC 10 Asbestos-cement
 2 Brass 4 Galvanized steel 6 Concrete tile 8 RMP (SR) 11 Other (specify) _____
 12 None used (open hole)
 SCREEN OR PERFORATION OPENINGS ARE:
 1 Continuous slot 3 Mill slot 5 Gauzed wrapped 8 Saw cut 11 None (open hole)
 2 Louvered shutter 4 Key punched 6 Wire wrapped 9 Drilled holes
 7 Torch cut 10 Other (specify) _____
 SCREEN-PERFORATED INTERVALS: From 227 ft. to 277 ft., From _____ ft. to _____ ft.
 GRAVEL PACK INTERVALS: From 24 ft. to 277 ft., From _____ ft. to _____ ft.

6 GROUT MATERIAL: 1 Neat cement 2 Cement grout 3 Bentonite 4 Other _____
 Grout intervals: From 4 ft. to 24 ft., From _____ ft. to _____ ft., From _____ ft. to _____ ft.
 What is the nearest source of possible contamination:
 1 Septic tank 4 Lateral lines 7 Pit privy 10 Livestock pens 14 Abandoned water well
 2 Sewer lines 5 Cess pool 8 Sewage lagoon 11 Fuel storage 15 Oil well/Gas well
 3 Watertight sewer lines 6 Seepage pit 9 Feedyard 12 Fertilizer storage 16 Other (specify below)
 13 Insecticide storage NONE

Direction from well? _____ How many feet? _____

FROM	TO	LITHOLOGIC LOG	FROM	TO	PLUGGING INTERVALS
0	2	Surface			
2	55	Sandy clay			
55	120	Medium to coarse sand			
120	160	Fine sand w/clay breakers			
160	195	Fine to medium sand			
195	220	Gray clay w/sand strips			
220	243	Coarse sand and gravel			
243	266	Gray clay and red sandstone			
266	300	Blue shale and hard rock			

7 CONTRACTOR'S OR LANDOWNER'S CERTIFICATION: This water well was (1) constructed, (2) reconstructed, or (3) plugged under my jurisdiction and was completed on (mo/day/year) October 24, 1995 and this record is true to the best of my knowledge and belief. Kansas Water Well Contractor's License No. 164 This Water Well Record was completed on (mo/day/yr) November 7, 1995 under the business name of Houck Bros. Drilling Co. by (signature) M. Beard