


1 LOCATION OF WATER WELL: Fraction SW 1/4 SW 1/4 SW 1/4 Section Number 8 Township Number T 30 S Range Number R 40 E/W  
 County: Stanton

Distance and direction from nearest town or city street address of well if located within city?  
 From Hwy Jct, 160 & 27, at Johnson Kansas, 9 miles south & 2 east

2 WATER WELL OWNER: Seaboard Farms, Inc. Shore #2  
 RR#, St. Address, Box #: P. O. Box 1029 Board of Agriculture, Division of Water Resources  
 City, State, ZIP Code: Hugoton, Kansas 67951 Application Number:

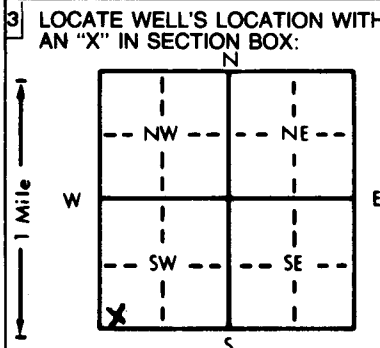

4 DEPTH OF COMPLETED WELL: 401 ft. ELEVATION: slope  
 Depth(s) Groundwater Encountered 1. 228 ft. 2. ft. 3. ft.  
 WELL'S STATIC WATER LEVEL 228 ft. below land surface measured on mo/day/yr 9-16-95  
 Pump test data: Well water was N/A after hours pumping gpm  
 Est. Yield gpm; Well water was N/A after hours pumping gpm  
 Bore Hole Diameter 14 1/2 in. to 401 ft. and in. to ft.  
 WELL WATER TO BE USED AS:  
 1 Domestic 3 Feedlot 6 Oil field water supply 9 Dewatering 12 Other (Specify below) STOCK  
 2 Irrigation 4 Industrial 7 Lawn and garden only 10 Monitoring well  
 Was a chemical/bacteriological sample submitted to Department? Yes No X; If yes, mo/day/yr sample was submitted  
 Water Well Disinfected? Yes X No

5 TYPE OF BLANK CASING USED:  
 1 Steel 3 RMP (SR) 5 Wrought iron 8 Concrete tile CASING JOINTS: Glued Clamped Welded Threaded  
 2 PVC 4 ABS 7 Fiberglass 9 Other (specify below)  
 Blank casing diameter 8 in. to 24.6 ft., Dia 8 in. to 27.6 ft., Dia 8 in. to 37.1 ft.  
 Casing height above land surface 20 in., weight schedule 200 SDR 21 lbs./ft. Wall thickness or gauge No.  
 TYPE OF SCREEN OR PERFORATION MATERIAL:  
 1 Steel 3 Stainless steel 5 Fiberglass 8 RMP (SR) 10 Asbestos-cement  
 2 Brass 4 Galvanized steel 6 Concrete tile 9 ABS 11 Other (specify)  
 12 None used (open hole)  
 SCREEN OR PERFORATION OPENINGS ARE:  
 1 Continuous slot 3 Mill slot 5 Gauzed wrapped 8 Saw cut 11 None (open hole)  
 2 Louvered shutter 4 Key punched 6 Wire wrapped 9 Drilled holes  
 7 Torch cut 10 Other (specify)  
 SCREEN-PERFORATED INTERVALS: From 24.6 ft. to 25.6 ft., From 27.6 ft. to 31.6 ft.  
 From 37.1 ft. to 40.1 ft., From ft. to ft.  
 GRAVEL PACK INTERVALS: From 24 ft. to 40.1 ft., From ft. to ft.  
 From ft. to ft., From ft. to ft.

6 GROUT MATERIAL: 1 Neat cement 2 Cement grout 3 Bentonite 4 Other  
 Grout Intervals: From 4 ft. to 24 ft., From ft. to ft., From ft. to ft.  
 What is the nearest source of possible contamination:  
 1 Septic tank 4 Lateral lines 7 Pit privy 10 Livestock pens 14 Abandoned water well  
 2 Sewer lines 5 Cess pool 8 Sewage lagoon 11 Fuel storage 15 Oil well/Gas well  
 3 Watertight sewer lines 6 Seepage pit 9 Feedyard 12 Fertilizer storage 16 Other (specify below) NONE  
 13 Insecticide storage  
 Direction from well? How many feet?

| FROM | TO  | LITHOLOGIC LOG                       | FROM | TO | PLUGGING INTERVALS |
|------|-----|--------------------------------------|------|----|--------------------|
| 0    | 2   | Surface                              |      |    |                    |
| 2    | 40  | Brown sandy clay                     |      |    |                    |
| 40   | 75  | Sandy clay w/fine sand & lime shells |      |    |                    |
| 75   | 135 | Medium to coarse sand w/cly breakers |      |    |                    |
| 135  | 160 | Brown clay                           |      |    |                    |
| 160  | 180 | Medium to coarse sand                |      |    |                    |
| 180  | 210 | Sandy clay                           |      |    |                    |
| 210  | 240 | Brown clay w/fine sand               |      |    |                    |
| 240  | 253 | Coarse sand                          |      |    |                    |
| 253  | 276 | Brown shale                          |      |    |                    |
| 276  | 295 | Brown shale w/sandstone              |      |    |                    |
| 295  | 316 | Brown shale w/sandstone strips       |      |    |                    |
| 316  | 375 | Brown and blue shale w/sandstone     |      |    |                    |
| 375  | 402 | Brown and blue shale w/sandstone     |      |    |                    |
| 402  | 405 | Rock                                 |      |    |                    |

7 CONTRACTOR'S OR LANDOWNER'S CERTIFICATION: This water well was (1) constructed (2) reconstructed, or (3) plugged under my jurisdiction and was completed on (mo/day/year) 9/11/95 and this record is true to the best of my knowledge and belief. Kansas Water Well Contractor's License No. 164 This Water Well Record was completed on (mo/day/yr) 9-27-95 under the business name of Houck Bros, Drilling Co. by (signature) M. Beard

INSTRUCTIONS: Use typewriter or ball point pen. PLEASE PRESS FIRMLY and PRINT clearly. Please fill in blanks, underline or circle the correct answers. Send top three copies to Kansas Department of Health and Environment, Bureau of Water, Topeka, Kansas 66620-0001. Telephone: 913-296-5545. Send one to WATER WELL OWNER and retain one for your records.