


1 LOCATION OF WATER WELL: County: Stanton Fraction: NW 1/4 NW 1/4 NW 1/4 Section Number: 25 Township Number: T 30 S Range Number: R 46 EW

Distance and direction from nearest town or city street address of well if located within city?
9 Miles South, 5 mile east, 2 mile south / Midwest 1/2 mile South of Johnson

2 WATER WELL OWNER: Gene Shore
 RR#, St. Address, Box #: RR, Board of Agriculture, Division of Water Resources
 City, State, ZIP Code: Johnson, Mo, 67855 Application Number:

3 LOCATE WELL'S LOCATION WITH AN "X" IN SECTION BOX:

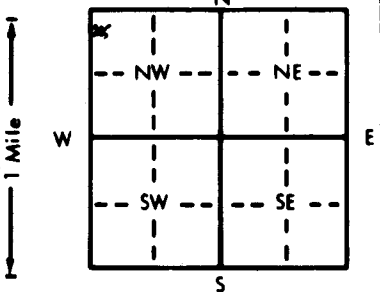

4 DEPTH OF COMPLETED WELL: 325' ft. ELEVATION:
 Depth(s) Groundwater Encountered: 1 265-275 ft. 2. 275-325 ft. 3. 325 ft.
 WELL'S STATIC WATER LEVEL: 210 ft. below land surface measured on 8/15/83 mo/day/yr
 Pump test data: Well water was 235' ft. after 12 hours pumping 15 gpm
 Est. Yield: 15 gpm; Well water was 235' ft. after 12 hours pumping 15 gpm
 Bore Hole Diameter: 12 1/4 in. to 325' ft., and 325' in. to 325' ft.

WELL WATER TO BE USED AS:
 1 Domestic Feedlot 6 Oil field water supply 9 Dewatering 12 Other (Specify below)
 2 Irrigation 4 Industrial 7 Lawn and garden only 10 Observation well 1
 Was a chemical/bacteriological sample submitted to Department? Yes No ; If yes, mo/day/yr sample was submitted
 Water Well Disinfected? Yes No

5 TYPE OF BLANK CASING USED:
 1 Steel 3 RMP (SR) 5 Wrought iron 8 Concrete tile CASING JOINTS: Glued Clamped
 PVC 4 ABS 7 Fiberglass 9 Other (specify below) Welded Threaded

Blank casing diameter: 5" in. to 265' ft., Dia. 265' in. to 325' ft., Dia. 325' in. to 325' ft.
 Casing height above land surface: 12" in., weight 200 PSI lbs./ft. Wall thickness or gauge No. 12

TYPE OF SCREEN OR PERFORATION MATERIAL:
 1 Steel 3 Stainless steel 5 Fiberglass PVC 10 Asbestos-cement
 2 Brass 4 Galvanized steel 6 Concrete tile 8 RMP (SR) 11 Other (specify) 1
 12 None used (open hole)

SCREEN OR PERFORATION OPENINGS ARE:
 1 Continuous slot Mill slot 5 Gauzed wrapped 8 Saw cut 11 None (open hole)
 2 Louvered shutter 4 Key punched 6 Wire wrapped 9 Drilled holes
 7 Torch cut 10 Other (specify) 1

SCREEN-PERFORATED INTERVALS: From 265' ft. to 325' ft., From 275' ft. to 325' ft., From 325' ft. to 325' ft.
 GRAVEL PACK INTERVALS: From 225' ft. to 325' ft., From 275' ft. to 325' ft., From 325' ft. to 325' ft.

6 GROUT MATERIAL: 1 Neat cement Cement grout 3 Bentonite 4 Other
 Grout Intervals: From 5' ft. to 20' ft., From 20' ft. to 325' ft., From 325' ft. to 325' ft.

What is the nearest source of possible contamination:
 1 Septic tank 4 Lateral lines 7 Pit privy 10 Livestock pens 14 Abandoned water well
 2 Sewer lines 5 Cess pool 8 Sewage lagoon 11 Fuel storage 15 Oil well/Gas well
 3 Watertight sewer lines 6 Seepage pit 9 Feedyard 12 Fertilizer storage 16 Other (specify below) N.A.
 13 Insecticide storage

Direction from well? How many feet?

FROM	TO	LITHOLOGIC LOG	FROM	TO	LITHOLOGIC LOG
0'	90'	sand.			
90'	120'	clay.			
120'	165'	sand.			
165'	200'	clay w/ strip fine sand.			
200'	210'	sand.			
210'	265'	clay w/ strip sandstone.			
265'	325'	sandstone.			

7 CONTRACTOR'S OR LANDOWNER'S CERTIFICATION: This water well was (1) constructed, (2) reconstructed, or (3) plugged under my jurisdiction and was completed on (mo/day/year) 9/15/83 and this record is true to the best of my knowledge and belief. Kansas Water Well Contractor's License No. 160 This Water Well Record was completed on (mo/day/yr) 5/18/84 under the business name of Jim Smith Pump Serv. by (signature) James R. Smith

INSTRUCTIONS: Use typewriter or ball point pen, PLEASE PRESS FIRMLY and PRINT clearly. Please fill in blanks, underline or circle the correct answers. Send top three copies to Kansas Department of Health and Environment, Division of Environment, Environmental Geology Section, Topeka, KS 66620. Send one to WATER WELL OWNER and retain one for your records.