


1 LOCATION OF WATER WELL: County: Stanton Fraction: Lot 2 1/4 NW 1/4 NE 1/4 Section Number: 6 Township Number: T 30 S Range Number: R 40 **EW**

Distance and direction from nearest town or city street address of well if located within city?  
 From Johnson approximately 6 south, 1/2 east

2 WATER WELL OWNER: Julian Farms  
 RR#, St. Address, Box # : RFD  
 City, State, ZIP Code : Johnson, KS 67855  
 Board of Agriculture, Division of Water Resources  
 Application Number: 8816

3 LOCATE WELL'S LOCATION WITH AN "X" IN SECTION BOX:

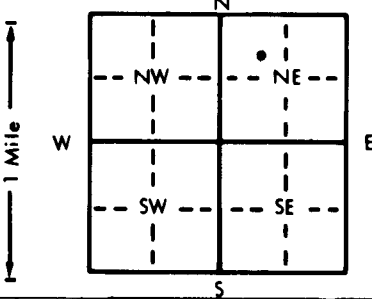

4 DEPTH OF COMPLETED WELL: 559 ft. ELEVATION: \_\_\_\_\_  
 Depth(s) Groundwater Encountered 1. \_\_\_\_\_ ft. 2. \_\_\_\_\_ ft. 3. \_\_\_\_\_ ft.  
 WELL'S STATIC WATER LEVEL: 260 ft. below land surface measured on mo/day/yr 5-20-85  
 Pump test data: Well water was \_\_\_\_\_ ft. after \_\_\_\_\_ hours pumping \_\_\_\_\_ gpm  
 Est. Yield .500 gpm: Well water was \_\_\_\_\_ ft. after \_\_\_\_\_ hours pumping \_\_\_\_\_ gpm  
 Bore Hole Diameter: .24 in. to .559 ft., and \_\_\_\_\_ in. to \_\_\_\_\_ ft.  
 WELL WATER TO BE USED AS:  
 1 Domestic 3 Feedlot 5 Public water supply 8 Air conditioning 11 Injection well  
 2 Irrigation 4 Industrial 6 Oil field water supply 9 Dewatering 12 Other (Specify below)  
 7 Lawn and garden only 10 Observation well  
 Was a chemical/bacteriological sample submitted to Department? Yes \_\_\_\_\_ No X If yes, mo/day/yr sample was submitted \_\_\_\_\_  
 Water Well Disinfected? Yes \_\_\_\_\_ No X

5 TYPE OF BLANK CASING USED:  
 1 Steel 3 RMP (SR) 5 Wrought iron 8 Concrete tile CASING JOINTS: Glued \_\_\_\_\_ Clamped \_\_\_\_\_  
 2 PVC 4 ABS 6 Asbestos-Cement 9 Other (specify below) Welded X  
 7 Fiberglass Threaded \_\_\_\_\_

Blank casing diameter: .16 in. to .559 ft., Dia \_\_\_\_\_ in. to \_\_\_\_\_ ft., Dia \_\_\_\_\_ in. to \_\_\_\_\_ ft.  
 Casing height above land surface: .12 in., weight 42.05 lbs./ft. Wall thickness or gauge No. .250"w

TYPE OF SCREEN OR PERFORATION MATERIAL:  
 1 Steel 3 Stainless steel 5 Fiberglass 7 PVC 10 Asbestos-cement  
 2 Brass 4 Galvanized steel 6 Concrete tile 8 RMP (SR) 11 Other (specify) \_\_\_\_\_  
 9 ABS 12 None used (open hole)

SCREEN OR PERFORATION OPENINGS ARE:  
 1 Continuous slot 3 Mill slot 5 Gauzed wrapped 8 Saw cut 11 None (open hole)  
 2 Louvered shutter 4 Key punched 6 Wire wrapped 9 Drilled holes  
 7 Torch cut 10 Other (specify) \_\_\_\_\_

SCREEN-PERFORATED INTERVALS: From 260 ft. to 310 ft., From 370 ft. to 556 ft.  
 From \_\_\_\_\_ ft. to \_\_\_\_\_ ft., From \_\_\_\_\_ ft. to \_\_\_\_\_ ft.  
 GRAVEL PACK INTERVALS: From 10 ft. to 559 ft., From \_\_\_\_\_ ft. to \_\_\_\_\_ ft.  
 From \_\_\_\_\_ ft. to \_\_\_\_\_ ft., From \_\_\_\_\_ ft. to \_\_\_\_\_ ft.

6 GROUT MATERIAL: 1 Neat cement 2 Cement grout 3 Bentonite 4 Other \_\_\_\_\_  
 Grout intervals: From 0 ft. to 10 ft., From \_\_\_\_\_ ft. to \_\_\_\_\_ ft., From \_\_\_\_\_ ft. to \_\_\_\_\_ ft.

What is the nearest source of possible contamination:  
 1 Septic tank 4 Lateral lines 7 Pit privy 10 Livestock pens 14 Abandoned water well  
 2 Sewer lines 5 Cess pool 8 Sewage lagoon 11 Fuel storage 15 Oil well/Gas well  
 3 Watertight sewer lines 6 Seepage pit 9 Feedyard 12 Fertilizer storage 16 Other (specify below)  
 13 Insecticide storage none observed

Direction from well? \_\_\_\_\_ How many feet? \_\_\_\_\_

FROM	TO	LITHOLOGIC LOG	FROM	TO	LITHOLOGIC LOG
		See attached log			

7 CONTRACTOR'S OR LANDOWNER'S CERTIFICATION: This water well was (1) constructed, (2) reconstructed, or (3) plugged under my jurisdiction and was completed on (mo/day/year) June 10, 1985 and this record is true to the best of my knowledge and belief. Kansas Water Well Contractor's License No. 145 This Water Well Record was completed on (mo/day/yr) July 3, 1985 under the business name of Henkle Drilling & Supply Co., Inc. by (signature) Bruce J. Reichmuth

INSTRUCTIONS: Use typewriter or ball point pen, PLEASE PRESS FIRMLY and PRINT clearly. Please fill in blanks, underline or circle the correct answers. Send top three copies to Kansas Department of Health and Environment, Division of Environment, Environmental Geology Section, Topeka, KS 66620. Send one to WATER WELL OWNER and retain one for your records.

CUSTOMERS NAME Julian Farms

DATE April 2, 1985

STREET ADDRESS \_\_\_\_\_

TRIP # 1 E 100 100

CITY & STATE Schroton, Kansas

DEPT. Livingston

COUNTY Stanton QUARTER NE SECTION 30

TOWNSHIP 30 RANGE 40

ELEVATION 80' east of the old well

#	Footage		DESCRIPTION OF STRATA	Static Water Level
	From	Pay To		Proposed Well Depth
	0		2 Top soil	
	2		41 Brown sandy clay and few sand st.	
	41		61 Sand fine to med.; small gravel	
	61		120 Brown clay - limestone	
	120		133 Brown sandy clay; fine sand st.	
	133		145 Sand fine to med. and clay st.	
	145		160 Sand fine to med.; small gravel	
	160		180 Brown sandy clay and fine sand st.	
	180		205 Sand fine to med.; small gravel	
	205		216 Brown sandy clay and few fine sand st.	
50	216	05	221 Sand fine to med.	
	221		250 Brown sandy clay, limestone	
35	250	10	260 Sand fine to med., coarse; small to med. brown gravel	
60	260	30	290 Sand fine to med., coarse; small to med. brown gravel and cemented st.	
	290		307 Clay	
20	297	15	307 Sandstone and sandstone; mixed bran, used lots of water	
	307		316 Soapstone, red, gray, and yellow	
	316		370 Weathered shale and few limestone lenses, few dakota st.	
20	370	10	380 Dakota and shale st.	
15	380	17	397 Shale and dakota	
	397		408 Red and gray shale, few dakota st.	
15	408	12	420 Dakota and few red shale, limestone st.; changed bit at 417'	
20	420	15	435 Dakota	
	435		441 Red shale	
30	441	115	556 Dakota, few soapstone and red shale st.	
			Used lots of water from 460 to 556; mixed bran	
	556		560 Red bed	
			Set up west	
			Pit on the north	
			2 sets of bits	
			1 sack of bran	