


USE TYPEWRITER OR BALL POINT PEN-PRESS FIRMLY, PRINT CLEARLY.

WATER WELL RECORD
KSA 82a-1201-1215

Kansas Department of Health and Environment-Division of Environment
(Water well Contractors)
Topeka, Kansas 66620

1. Location of well:	County Stanton	Fraction NW 1/4 NW 1/4 NW 1/4	Section number 7	Township number T 30 S R 40	Range number 40
----------------------	--------------------------	---	----------------------------	---------------------------------------	---------------------------

2. Distance and direction from nearest town or city: Street address of well location if in city:	from 160-270 Hwy 7 south, 1 1/2 east, 1 south	3. Owner of well: R.R. or street: City, state, zip code:	Irene Lowe & Jennifer Johnson % Vern Thompson Johnson, Ks. 67855
---	--	--	---

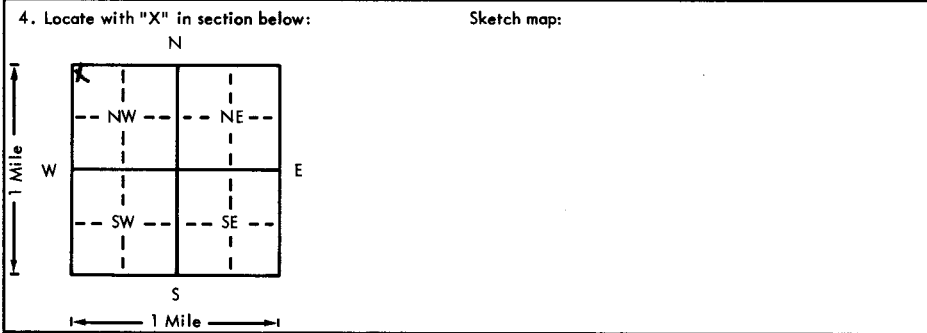

6. Bore hole dia. <u>27</u> in. Completion date _____ Well depth <u>322</u> ft. <u>6/15/77</u>
7. <input type="checkbox"/> Cable tool <input checked="" type="checkbox"/> Rotary <input type="checkbox"/> Driven <input type="checkbox"/> Dug <input type="checkbox"/> Hollow rod <input type="checkbox"/> Jetted <input type="checkbox"/> Bored <input type="checkbox"/> Reverse rotary
8. Use: <input type="checkbox"/> Domestic <input type="checkbox"/> Public supply <input type="checkbox"/> Industry <input checked="" type="checkbox"/> Irrigation <input type="checkbox"/> Air conditioning <input type="checkbox"/> Stock <input type="checkbox"/> Lawn <input type="checkbox"/> Oil field water <input type="checkbox"/> Other
9. Casing: Material <u>steel</u> Height <u>Above</u> or below Threaded _____ Welded <input checked="" type="checkbox"/> Surface <u>12</u> in. RMP _____ PVC _____ Weight <u>36.8</u> lbs./ft. Dia. <u>16</u> in. to <u>208</u> ft. depth Wall Thickness: inches or Dia. _____ in. to _____ ft. depth Gauge No. <u>219</u>

5. Type and color of material	From	To
Surface	0	2
Brown sandy clay	2	34
Red sandy clay & lime shells	34	78
Brown sandy clay, lime shells	78	96
Fine to coarse sand w/clay breakers	96	144
Brown sandy clay, lime shells w/embedded sand strips	144	174
Brown sandy clay, lime shells, fine to coarse sand strips	174	183
Fine to coarse sand w/clay breakers & strips of gravel & lime shells	183	196
Fine to coarse sand, tight to cemented	196	202
Fine to coarse sand, brown sandstone loose	202	210
Brown sandstone	210	220
Gray shale, pink clay & rock strips	220	228
Gray shale and Dakota	228	255
Gray shale and white Dakota	255	270
Gray shale, white and red Dakota	270	281
Blue shale, yellow chlak w/tight Dakota strips (Use a second sheet if needed)	281	302

10. Screen: Manufacturer's name <u>Lakewood</u> <u>Pipe of Texas</u> Type <u>steel</u> Dia. <u>16"</u> Slot/gauze <u>3/16"</u> Length <u>113.11'</u> Set between <u>208.1</u> ft. and <u>322</u> ft. _____ ft. and _____ ft. Gravel pack? <input checked="" type="checkbox"/> Size range of material <u>1/4 x 5/8"</u>
11. Static water level: _____ mo./day/yr. <u>218</u> ft. below land surface Date <u>5/14/77</u>
12. Pumping level below land surfaces: <u>248</u> ft. after <u>8</u> hrs. pumping <u>550</u> g.p.m. <u>275</u> ft. after <u>28</u> hrs. pumping <u>650</u> g.p.m. Estimated maximum yield <u>750</u> g.p.m.
13. Water sample submitted: _____ mo./day/yr. Yes <input checked="" type="checkbox"/> No <input type="checkbox"/> Date _____
14. Well head completion: <input type="checkbox"/> Pitless adapter <u>12</u> inches above grade
15. Well grouted? <input checked="" type="checkbox"/> With: <input checked="" type="checkbox"/> Neat cement <input type="checkbox"/> Bentonite <input type="checkbox"/> Concrete Depth: From <u>0</u> ft. to <u>10</u> ft.
16. Nearest source of possible contamination: ft. _____ Direction _____ Type <u>field</u> Well disinfected upon completion? Yes <input type="checkbox"/> No <input checked="" type="checkbox"/>
17. Pump: <input checked="" type="checkbox"/> Not installed Manufacturer's name _____ HP _____ Volts _____ Model number _____ Length of drop pipe _____ ft. capacity _____ g.p.m. Type: <input type="checkbox"/> Submersible <input type="checkbox"/> Turbine <input type="checkbox"/> Jet <input type="checkbox"/> Reciprocating <input type="checkbox"/> Centrifugal <input type="checkbox"/> Other

18. Elevation:	19. Remarks:
Topography: <input type="checkbox"/> Hill <input checked="" type="checkbox"/> Slope <input type="checkbox"/> Upland <input type="checkbox"/> Valley	

20. Water well contractor's certification: This well was drilled under my jurisdiction and this report is true to the best of my knowledge and belief. <u>Houck Bros. Drlg. Co.</u> <u>164</u> Business name license No. Address <u>Box 487, Ulysses, Ks.</u> Signed <u>M. Beard</u> Date <u>7/22/77</u> Authorized representative
--

30 40' 7 1/4 1/4 1/4