

USE TYPEWRITER OR BALL POINT PEN—PRESS FIRMLY, PRINT CLEARLY.

T R EW sec 1/4 1/4 1/4 No.


WATER WELL RECORD
KSA 82a-1201-1215

Kansas State Dept. Of Health
(Water Well Contractors)
Forbes-Bldg. 740
Topeka, Kansas 66620

1 Location of well:	County Stanton	Township name	Fraction NW¹/₄, NW²/₄, NW³/₄	Section number 12	Town number T30S	Range number R40W
---------------------	--------------------------	---------------	--	-----------------------------	----------------------------	-----------------------------

Distance and direction from nearest town or city:
8 mi. south, 4 mi. west & south from Big Bow
Street address of well location if in city:

3 Owner of well: **Royce Snook**
Address: **Highway 160 East Ulysses, Kansas 67880**

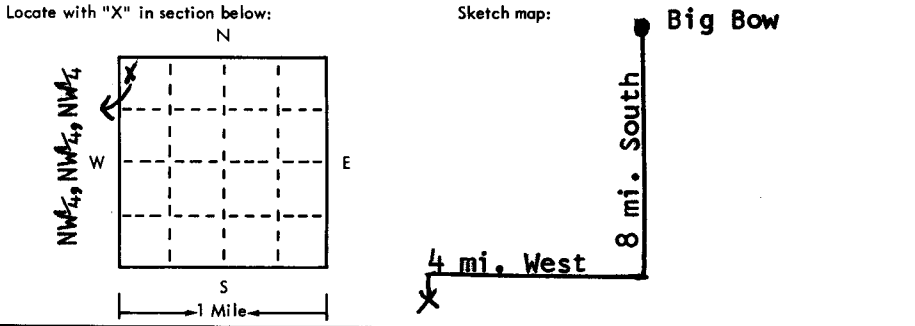

4 Well depth: **405** ft. Date of completion _____
Well diameter **26** in.

5 Cable tool Rotary Driven Dug
 Hollow rod Jetted Bored Reverse rotary

6 Use: Domestic Public supply Industry
 Irrigation Air conditioning Commercial
 Test well

7 Casing: Material **Steel** Height: above/below
Threaded Welded Surface **12** in.
Diam. _____ Weight **34.5** lbs./ft. _____
16 in. to **405** ft. depth Drive shoe? Yes No
_____ in. to _____ ft. depth

2 Type and color of material	From	To
Surface & Fine Sand	0	15
Fine Sand	15	45
Brown Clay	45	150
Sand	150	180
Brown Clay	180	195
Coarse Sand	195	255
Brown Clay	255	310
Coarse Sand	310	345
Brown Clay	345	350
Coarse Sand	350	390
Coarse Sand & Brown Clay Strips	390	405
Brown Weathered XXXX Shale & Yellow Chalk	405	435
(use a second sheet if needed)		

8 Screen:
Manufacturer **Johnson**
Type **Galvanized** Dia. **16** in.
Slot ~~width~~ **100X100** Length **50** ft.
Set between **245** ft. and **255** ft. **325 & 345**
Fittings: * **See Remarks 365 & 385**
Gravel pack Yes No Size range of material **down**

9 Static water level:
193 ft. below land surface Date **4-3-76**

10 Pumping level below land surfaces:
240 ft. after **4** hrs. pumping **1000** g.p.m.
_____ ft. after _____ hrs. pumping _____ g.p.m.
Estimated maximum yield **1200** g.p.m.

11 Water sample submitted:
 Yes No Date _____

12 Well head completion: **12** in.
 Pitless adapter Inches above grade

13 Well grouted? Yes No
 Neat cement Bentonite _____
Depth: From **0** ft. to **10** ft.

14 Nearest source of possible contamination:
ft. _____ Direction **none in field** Type _____
Well disinfected upon completion? Yes No

15 Pump: Not installed
Manufacturer's name **Goulds**
Model number **121** HP **200** Volts _____
Length of drop pipe **380** ft. capacity **1200** g.p.m.
Type:
 Submersible Turbine
 Jet Reciprocating
 Centrifugal Other

16 Remarks: elevation **Drilling Sub-contracted to: Clemens Irrigation Liberal, Kansas 67901**
Topography: Hill Slope Upland Valley
*** Lakewood Perf - Slot - 125 X 66 Set Between 310' & 325', 345' & 365', 385' & 405'**

17 Water well contractor's certification:
This well was drilled under my jurisdiction and this report is true to the best of my knowledge and belief.
K. I. Drilling Co., Inc. 263
Business name _____ License No. _____
Address **Box 669, Ulysses, Kan. 67880**
Signed **M. Joyce Bunker** Date **4-20-76**
Authorized representative

30 40W 12 NW 1/4 12