


1 LOCATION OF WATER WELL: Fraction NW 1/4 SW 1/4 SW 1/4 Section Number 22 Township Number T 30 S Range Number R 40 EW
 County: Stanton

Distance and direction from nearest town or city street address of well if located within city?
From Johnson 8 south # 5E 1 1/2 S 1/2 W

2 WATER WELL OWNER: Harold Shore (Jone)
 RR#, St. Address, Box #: Rt 2 Box 38AA
 City, State, ZIP Code: Johnson Ks 67855
 Board of Agriculture, Division of Water Resources
 Application Number: 4641

3 LOCATE WELL'S LOCATION WITH AN "X" IN SECTION BOX:

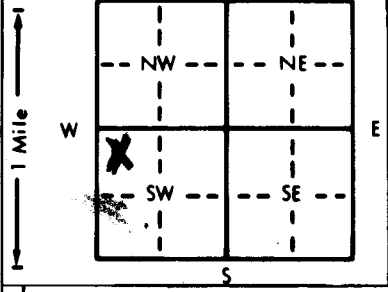

4 DEPTH OF COMPLETED WELL: 475 ft. ELEVATION:

Depth(s) Groundwater Encountered: 20 ft. 2. 330 ft. 3. ft.
 WELL'S STATIC WATER LEVEL: 20 ft. below land surface measured on mo/day/yr
 Pump test data: Well water was ft. after hours pumping gpm
 Est. Yield 250 gpm: Well water was ft. after hours pumping gpm
 Bore Hole Diameter: 30 in. to ft., and in. to ft.
 WELL WATER TO BE USED AS:
 1 Domestic 3 Feedlot 6 Oil field water supply 9 Dewatering 12 Other (Specify below)
2 Irrigation 4 Industrial 7 Lawn and garden only 10 Observation well
 Was a chemical/bacteriological sample submitted to Department? Yes..... No X.....; If yes, mo/day/yr sample was submitted
 Water Well Disinfected? Yes No X

5 TYPE OF BLANK CASING USED:
Steel 3 RMP (SR) 5 Wrought iron 8 Concrete tile CASING JOINTS: Glued Clamped
 2 PVC 4 ABS 6 Asbestos-Cement 9 Other (specify below) Welded
 7 Fiberglass Threaded.....

Blank casing diameter: 16 in. to 340 ft., Dia in. to ft., Dia in. to ft.
 Casing height above land surface: 12 in., weight 46 lbs./ft. Wall thickness or gauge No. 1250

TYPE OF SCREEN OR PERFORATION MATERIAL:
Steel 3 Stainless steel 5 Fiberglass 8 RMP (SR) 10 Asbestos-cement
 2 Brass 4 Galvanized steel 6 Concrete tile 9 ABS 12 None used (open hole)

SCREEN OR PERFORATION OPENINGS ARE:
 1 Continuous slot 3 Mill slot 6 Wire wrapped 8 Saw cut 11 None (open hole)
 2 Louvered shutter 4 Key punched 7 Torch cut 10 Other (specify)

SCREEN-PERFORATED INTERVALS: From 325 ft. to 485 ft., From ft. to ft.
 GRAVEL PACK INTERVALS: From ft. to ft., From ft. to ft.

6 GROUT MATERIAL: 1 Neat cement 2 Cement grout 3 Bentonite 4 Other

Grout intervals: From 0 ft. to 20 ft., From ft. to ft., From ft. to ft.
 What is the nearest source of possible contamination:
 1 Septic tank 4 Lateral lines 7 Pit privy 10 Livestock pens 14 Abandoned water well
 2 Sewer lines 5 Cess pool 8 Sewage lagoon 11 Fuel storage 15 Oil well/Gas well
 3 Watertight sewer lines 6 Seepage pit 9 Feedyard 12 Fertilizer storage 16 Other (specify below)
 13 Insecticide storage none

Direction from well? How many feet?

| FROM | TO | LITHOLOGIC LOG | FROM | TO | LITHOLOGIC LOG |
|------|-----|----------------------|------|-----|----------------|
| 0 | 55 | overburden & Clay | 430 | 440 | Shale |
| 55 | 155 | Sand & Clay | 440 | 475 | DKS soft |
| 155 | 174 | Cemented Sand | | | |
| 174 | 197 | Sand & Cemented Sand | | | |
| 197 | 202 | Clay | | | |
| 202 | 244 | Sand & gravel | | | |
| 244 | 282 | Shale | | | |
| 282 | 285 | Lime rock (gray) | | | |
| 285 | 289 | Shale | | | |
| 289 | 295 | lime rock (gray) | | | |
| 295 | 319 | Shale | | | |
| 319 | 330 | DKS | | | |
| 330 | 352 | Red DKS (Broken) | | | |
| 352 | 358 | Shale | | | |
| 358 | 430 | DKS | | | |

7 CONTRACTOR'S OR LANDOWNER'S CERTIFICATION: This water well was (1) constructed, (2) reconstructed, or (3) plugged under my jurisdiction and was completed on (mo/day/year) 3-23-89 and this record is true to the best of my knowledge and belief. Kansas
 Water Well Contractor's License No. 300 This Water Well Record was completed on (mo/day/yr) 8-30-89
 under the business name of Fulton Drilling by (signature)