


1] LOCATION OF WATER WELL: Fraction Section Number Township Number Range Number
 County: Stanton SW 1/4 SW 1/4 SW 1/4 26 T 30 S R 40 E

Distance and direction from nearest town or city street address of well if located within city?

11 south, 5 east of Johnson, Kansas

2] WATER WELL OWNER: Kendall Herrick
 RR#, St. Address, Box #: Route 2
 City, State, ZIP Code: Johnson, Kansas 67855
 Board of Agriculture, Division of Water Resources
 Application Number:

3] LOCATE WELL'S LOCATION WITH AN "X" IN SECTION BOX: 4] DEPTH OF COMPLETED WELL: 260 ft. ELEVATION: slope

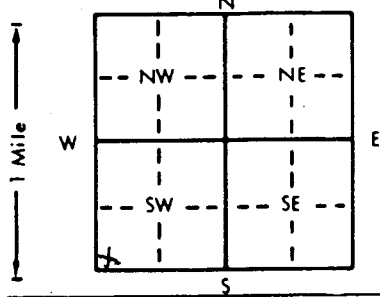

Depth(s) Groundwater Encountered 1. 215 ft. 2. _____ ft. 3. _____ ft.
 WELL'S STATIC WATER LEVEL 215 ft. below land surface measured on mo/day/yr 9/3/92
 Pump test data: Well water was 230 ft. after 10 hours pumping 10 gpm
 Est. Yield 20 gpm: Well water was _____ ft. after _____ hours pumping _____ gpm
 Bore Hole Diameter 9 7/8 in. to 260 ft. and _____ in. to _____ ft.
 WELL WATER TO BE USED AS: 5 Public water supply 8 Air conditioning 11 Injection well
 1 Domestic 3 Feedlot 6 Oil field water supply 9 Dewatering 12 Other (Specify below)
 2 Irrigation 4 Industrial 7 Lawn and garden only 10 Monitoring well
 Was a chemical/bacteriological sample submitted to Department? Yes _____ No x If yes, mo/day/yr sample was submitted
 Water Well Disinfected? Yes x No

5] TYPE OF BLANK CASING USED: 5 Wrought iron 8 Concrete tile CASING JOINTS: Glued x Clamped
 1 Steel 3 RMP (SR) 6 Asbestos-Cement 9 Other (specify below) & riveted
 2 PVC 4 ABS 7 Fiberglass Threaded

Blank casing diameter 5 in. to 220 ft. Dia _____ in. to _____ ft. Dia _____ in. to _____ ft.
 Casing height above land surface 18 in., weight _____ schedule 200 lbs./ft. Wall thickness or gauge No. _____

TYPE OF SCREEN OR PERFORATION MATERIAL: 7 PVC 10 Asbestos-cement
 1 Steel 3 Stainless steel 5 Fiberglass 8 RMP (SR) 11 Other (specify)
 2 Brass 4 Galvanized steel 6 Concrete tile 9 ABS 12 None used (open hole)

SCREEN OR PERFORATION OPENINGS ARE: 5 Gauzed wrapped 8 Saw cut 11 None (open hole)
 1 Continuous slot 3 Mill slot 6 Wire wrapped 9 Drilled holes
 2 Louvered shutter 4 Key punched 7 Torch cut 10 Other (specify)

SCREEN-PERFORATED INTERVALS: From 220 ft. to 260 ft. From _____ ft. to _____ ft.
 From _____ ft. to _____ ft. From _____ ft. to _____ ft.
 GRAVEL PACK INTERVALS: From 24 20 ft. to 260 ft. From _____ ft. to _____ ft.
 From _____ ft. to _____ ft. From _____ ft. to _____ ft.

6] GROUT MATERIAL: 1 Neat cement 2 Cement grout 3 Bentonite 4 Other
 Grout Intervals: From 0 4 ft. to 24 20 ft. From _____ ft. to _____ ft. From _____ ft. to _____ ft.

What is the nearest source of possible contamination:
 1 Septic tank 4 Lateral lines 7 Pit privy 10 Livestock pens 14 Abandoned water well
 2 Sewer lines 5 Cess pool 8 Sewage lagoon 11 Fuel storage 15 Oil well/Gas well
 3 Watertight sewer lines 6 Seepage pit 9 Feedyard 12 Fertilizer storage 16 Other (specify below)
 13 Insecticide storage
 Direction from well? north How many feet? 150 ft.

FROM	TO	LITHOLOGIC LOG	FROM	TO	PLUGGING INTERVALS
0	2	Surface			
2	20	Sandy clay w/fine sand			
20	45	Fine sand			
45	70	Brown clay w/lime shells			
70	110	Coarse sand			
110	120	Yellow clay and tight sandstone			
120	150	Yellow clay			
150	180	Red & gray clay w/sandstone			
180	220	Sandstone (tight)			
220	228	sandstone			
228	237	Sandstone (tight)			
237	260	Blue shale w/sandstone strips			
260	265	Blue shale and rock			

7] CONTRACTOR'S OR LANDOWNER'S CERTIFICATION: This water well was (1) constructed, (2) reconstructed, or (3) plugged under my jurisdiction and was completed on (mo/day/year) September 3, 1992 and this record is true to the best of my knowledge and belief. Kansas Water Well Contractor's License No. 164 This Water Well Record was completed on (mo/day/yr) September 14, 1992 under the business name of Houck Bros. Drilling Co. by (signature) M. Beard