


USE TYPEWRITER OR BALL POINT PEN-PRESS FIRMLY, PRINT CLEARLY.

WATER WELL RECORD
KSA 82a-1201-1215

Kansas Department of Health and Environment-Division of Environment
(Water well Contractors)
Topeka, Kansas 66620

1. Location of well:	County Stanton	Fraction NW 1/4 NE 1/4 NE 1/4	Section number 36	Township number T 30 S R	Range number 40 E W
2. Distance and direction from nearest town or city: Approximately 11 miles NE of Richfield, Kansas Street address of well location if in city:			3. Owner of well: Gene Shore R.R. or street: Johnson, Kansas 67855 City, state, zip code:		
4. Locate with "X" in section below: N  W E S			Sketch map:		
5. Type and color of material			From		To
6. Bore hole dia. <u>11</u> in. Completion date <u>12/1/77</u> Well depth <u>318</u> ft.			7. <input checked="" type="checkbox"/> Cable tool <input checked="" type="checkbox"/> Rotary <input type="checkbox"/> Driven <input type="checkbox"/> Dug <input type="checkbox"/> Hollow rod <input type="checkbox"/> Jetted <input type="checkbox"/> Bored <input type="checkbox"/> Reverse rotary		
8. Use: <input checked="" type="checkbox"/> Domestic <input type="checkbox"/> Public supply <input type="checkbox"/> Industry <input type="checkbox"/> Irrigation <input type="checkbox"/> Air conditioning <input type="checkbox"/> Stock <input type="checkbox"/> Lawn <input type="checkbox"/> Oil field water <input type="checkbox"/> Other			9. Casing material <u>Plastic</u> Height: Above or below <u>Graded</u> Threading: <input type="checkbox"/> Welded <input type="checkbox"/> Surface <u>12</u> in. RMP <u>5</u> PVC <input checked="" type="checkbox"/> Weight <u>4</u> lbs./ft. Dia. <u>6 5/8</u> in. to <u>318</u> ft. depth; Wall Thickness: inches or Dia. <u> </u> in. to <u> </u> ft. depth; Gauge No. <u>316</u>		
10. Screen: Manufacturer's name <u>Jet Stream</u> Type <u>P.V.C.</u> Dia. <u>6 5/8"</u> Slot/gauze <u>.040</u> Length <u>70'</u> Set between <u>190-</u> ft. and <u>200'</u> ft. <u>260-318</u> ft. and <u> </u> ft. Gravel pack? <u>Yes</u> Size range of material <u>8-12</u> Fountain			11. Static water level: <u>165</u> ft. below land surface Date <u>12/1/77</u> mo./day/yr.		
12. Pumping level below land surfaces: <u>Not Pumped</u> <u> </u> ft. after <u> </u> hrs. pumping <u> </u> g.p.m. <u> </u> ft. after <u> </u> hrs. pumping <u> </u> g.p.m. Estimated maximum yield <u>50</u> g.p.m.			13. Water sample submitted: <u> </u> mo./day/yr. <input type="checkbox"/> Yes <input checked="" type="checkbox"/> No Date <u> </u>		
14. Well head completion: <input checked="" type="checkbox"/> Pitless adapter <u>12</u> Inches above grade			15. Well grouted? <u>Yes</u> With: <input checked="" type="checkbox"/> Neat cement <input type="checkbox"/> Bentonite <input type="checkbox"/> Concrete Depth: From <u>0</u> ft. to <u>10</u> ft.		
16. Nearest source of possible contamination: ft. <u>150'</u> Direction <u>NE</u> Type <u>Sewer line</u> Well disinfected upon completion? <input checked="" type="checkbox"/> Yes <input type="checkbox"/> No			17. Pump: <input checked="" type="checkbox"/> Not installed Manufacturer's name <u> </u> Model number <u> </u> HP <u> </u> Volts <u> </u> Length of drop pipe <u> </u> ft. capacity <u> </u> g.p.m. Type: <input type="checkbox"/> Submersible <input type="checkbox"/> Turbine <input type="checkbox"/> Jet <input type="checkbox"/> Reciprocating <input type="checkbox"/> Centrifugal <input type="checkbox"/> Other		
18. Elevation: <u>x Flat</u> Topography: <input type="checkbox"/> Hill <input type="checkbox"/> Slope <input type="checkbox"/> Upland <input type="checkbox"/> Valley			19. Remarks:		
			20. Water well contractor's certification: This well was drilled under my jurisdiction and this report is true to the best of my knowledge and belief. Henkle Drilling & Sply 145 Business name <u> </u> License No. <u> </u> Address <u>Box 639, Garden City, Ks</u> Signed <u>Barry Reichmuth</u> Date <u>12/2/77</u> Authorized representative		

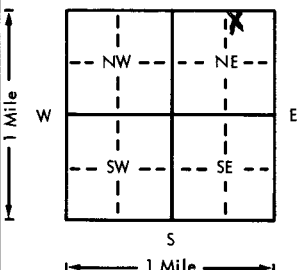