USE TYPEWRITER OR BALL POINT PEN-PRESS FIRMLY, PRINT CLEARLY.

WATER WELL RECORD
KSA 82a-1201-1215

Kansas Department of Health and Environment-Division of Environment
(Water well Contractors)
Topeka, Kansas 66620

CWW Inv. #13971 Kane Bockman #1

1. Location of well:	County	Fraction	Section number	Township number	Range number
	Stanton	SW 1/4 SW 1/4 NW 1/4	23	T 30N S	R 41W E/W

2. Distance and direction from nearest town or city: Go north of Richfield on Hwy 27 -9m to Stanton Co. line then 3m No.-1m W-½m So-East to
Street address of well location if in city:

3. Owner of well: Sage drilling Company
R. or street: 500 Bitting Building
City, state, zip code: Wichita, KS 67202

4. Locate with "X" in section below:

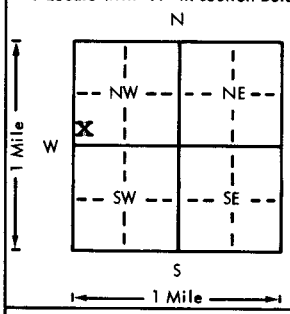

Sketch map: location west east to loc. Stanton Co. LINE Norton Hwy 27 Richfield

5. Type and color of material	From	To
Surface	0	2
Clay	2	20
Fine sand & medium to small sand	20	75
Sandy clay	75	160
Medium to small sand	160	225
Blue clay	225	240

(Use a second sheet if needed)

6. Bore hole dia. 9 in. Completion date 10-28-77
Well depth 240 ft.

7. __ Cable tool X Rotary __ Driven __ Dug
__ Hollow rod __ Jetted __ Bored __ Reverse rotary

8. Use: __ Domestic __ Public supply X Industry
__ Irrigation __ Air conditioning __ Stock
__ Lawn X Oil field water __ Other

9. Casing: Material ____ Height: Above or below
Threaded ____ Welded ____ Surface 28 in.
RMP ____ PVC X Weight 2.78 lbs./ft.
Dia. 5 in. to 155 ft. depth Wall Thickness: inches or
Dia. 5 in. to 240 ft. depth gage No. .265

10. Screen: Manufacturer's name Sawed perf.
Type PVC Dia. 5"
Slot/gauze .030 Length 80'
Set between 155 ft. and 235 ft.
____ ft. and ____ ft.
Gravel pack? yes Size range of material 1/8-3/16

11. Static water level: mo./day/yr.
185 ft. below land surface Date 10-28-77

12. Pumping level below land surfaces:
____ ft. after ____ hrs. pumping ____ g.p.m.
____ ft. after ____ hrs. pumping ____ g.p.m.
Estimated maximum yield 40 g.p.m.

13. Water sample submitted: mo./day/yr.
__ Yes X No Date ____

14. Well head completion:
__ Pitless adapter 28 Inches above grade

15. Well grouted? yes
With: X Neat cement __ Bentonite __ Concrete
Depth: From 0 ft. to 10 ft.

16. Nearest source of possible contamination:
ft. 100 Direction NE Type oilwell
Well disinfected upon completion? X Yes __ No

17. Pump: X Not installed
Manufacturer's name ____
Model number ____ HP ____ Volts ____
Length of drop pipe ____ ft. capacity ____ g.p.m.
Type:
__ Submersible __ Turbine
__ Jet __ Reciprocating
__ Centrifugal __ Other

18. Elevation:

Topography:
__ Hill
__ Slope
X Upland
__ Valley

19. Remarks:

20. Water well contractor's certification:
This well was drilled under my jurisdiction and this report is true to the best of my knowledge and belief.
Carlile Water Well's 118
Business name License No.
Address Box 275, Liberal, KS
Signed Edward E. Means Date 11-8-77
Authorized representative

T 30 R 41 E/W Sec 23 1/4 SW 1/4 1/4 1/4

Forward the white, blue and pink copies to the Department of Health and Environment

Form WWC-5