

USE TYPEWRITER OR BALL  
POINT PEN-PRESS FIRMLY,  
PRINT CLEARLY.


WATER WELL RECORD  
KSA 82a-1201-1215

T R EW sec 1/4 1/4 1/4 No.

Kansas State Dept. Of Health  
(Water Well Contractors)  
Forbes-Bldg. 740  
Topeka, Kansas 66620

1 Location of well:	County <b>Stanton</b>	Township name	Fraction N.E. 1/4 of S.E. 1/4	Section number <b>16</b>	Town number <b>30</b>	Range number <b>43</b>
---------------------	--------------------------	---------------	-------------------------------------	-----------------------------	--------------------------	---------------------------

Distance and direction from nearest town or city: <b>5 mi. S. of Saunders</b> Street address of well location if in city:	3 Owner of well: <b>J. D. Bitner</b> Address: <b>Manter, Kansas 67862</b>
---	--

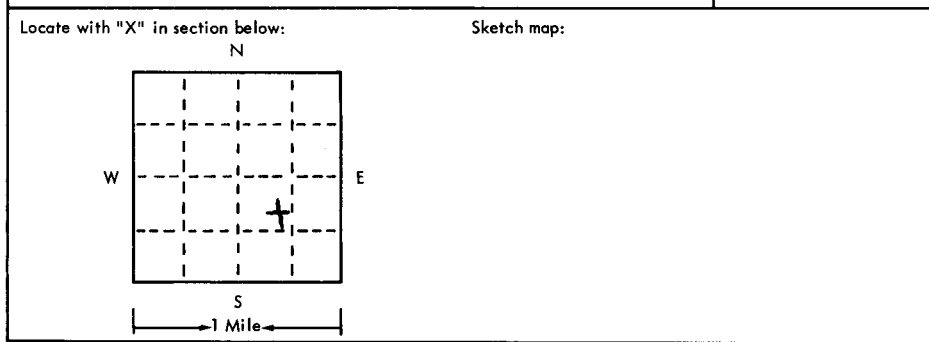

4 Well depth: 140 ft. Date of completion 3-15-75  
Well diameter 6 7/8 in.

5  Cable tool  Rotary  Driven  Dug  
 Hollow rod  Jetted  Bored  Reverse rotary

6 Use:  Domestic  Public supply  Industry  
 Irrigation  Air conditioning  Commercial  
 Test well  **stock**

7 Casing: Material pvc Height: above/below  
Threaded  Welded  Surface 18 in.  
**cemented** Diam. 5 in. to 140 ft. depth Weight \_\_\_\_\_ lbs./ft. Drive shoe?  Yes  No

2 Type and color of material		From	To
Soil and subsoil		1	5
Rock white hard		5	17
Sandstone soft dry		17	22
Sand fine soft dry		22	34
Gravel soft dry		34	51
Yellow sandstone occasional hard streaks		63	94
White clay streaks sandstone		94	105
Yellow sandstone soft (uses water)		105	130
Soft brown sandstone (uses water)		130	140
(use a second sheet if needed)			

8 Screen: perforated by driller  
Manufacturer \_\_\_\_\_  
Type pvc Dia. 5 in.  
Slot/gauze 1/4 x 3 Length 20 ft.  
Set between 120 ft. and 140 ft. Fittings:  
Gravel pack  Yes  No Size range of material \_\_\_\_\_

9 Static water level:  
80 ft. below land surface Date 3-15-75

10 Pumping level below land surfaces:  
\_\_\_\_ ft. after \_\_\_\_\_ hrs. pumping \_\_\_\_\_ g.p.m.  
\_\_\_\_ ft. after \_\_\_\_\_ hrs. pumping \_\_\_\_\_ g.p.m.  
Estimated maximum yield \_\_\_\_\_ g.p.m.

11 Water sample submitted:  
 Yes  No Date \_\_\_\_\_

12 Well head completion:  
 Pitless adapter  Inches above grade

13 Well grouted?  Yes  No  
 Neat cement  Bentonite  Concrete  
Depth: From 12 in. above to 10 in. below

14 Nearest source of possible contamination: none  
ft. \_\_\_\_\_ Direction \_\_\_\_\_ Type \_\_\_\_\_  
Well disinfected upon completion?  Yes  No

15 Pump:  Not installed  
Manufacturer's name \_\_\_\_\_  
Model number \_\_\_\_\_ HP \_\_\_\_\_ Volts \_\_\_\_\_  
Length of drop pipe \_\_\_\_\_ ft. capacity \_\_\_\_\_ g.p.m.  
Type: windmill to be installed later  
 Submersible  Turbine  Jet  Reciprocating  
 Centrifugal  Other

16 Remarks: elevation

Topography:  
 Hill  
 Slope  
 Upland  
 Valley

17 Water well contractor's certification:  
This well was drilled under my jurisdiction and this report is true to the best of my knowledge and belief.  
**Delay Drilling** 231  
Business name \_\_\_\_\_ License No. \_\_\_\_\_  
Address Manter, Kans. 67862  
Signed Oliver Delay Date 3-14-75  
Authorized representative