

USE TYPEWRITER OR BALL POINT PEN—PRESS FIRMLY, PRINT CLEARLY.

T R EW sec 1/4 1/4 1/4 No.


WATER WELL RECORD
KSA 82a-1201-1215

Kansas State Dept. Of Health
(Water Well Contractors)
Forbes-Bldg. 740
Topeka, Kansas 66620

1 Location of well: County *STANTON* Township name *MANter* Fraction *NWSESE 1/4* Section number *29* Town number *300* Range number *43W*

Distance and direction from nearest town or city: *55*
Street address of well location if in city: *SAUNDERS-KANS.*

3 Owner of well: *ARDEIN DILLINGER*
Address: *WALSH-COLO, 81090*

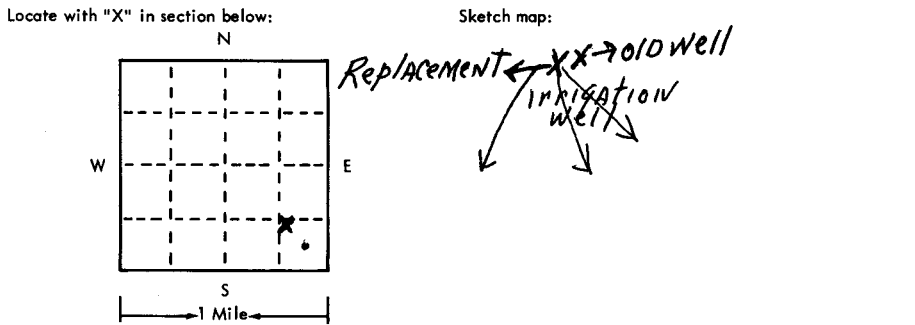

4 Well depth: *98* ft. Date of completion *4-26-76*
Well diameter *18* in.

5 Cable tool Rotary Driven Dug
 Hollow rod Jetted Bored Reverse rotary

6 Use: Domestic Public supply Industry
 Irrigation Air conditioning Commercial
 Test well

7 Casing: Material *Steel* Height: above / below
Threaded Welded Surface *24* in.
Diam. *14"* Weight ~~*27*~~ lbs *27.66#*
14 in. to *98* ft. depth Drive shoe? Yes No
___ in. to ___ ft. depth

2	Type and color of material	From	To
	<i>TOPSOIL</i>	<i>0</i>	<i>12</i>
	<i>SAND FINE BROWN</i>	<i>12</i>	<i>24</i>
	<i>SAND & GRAVEL LOOSE CLEAN</i>	<i>24</i>	<i>50</i>
	<i>SAND & GRAVEL COARSE-CLEAN-LOOSE</i>	<i>50</i>	<i>77</i>
	<i>CLAY GRAY & YELLOW</i>	<i>77</i>	<i>88</i>
	<i>SHALE BLACK</i>	<i>88</i>	<i>98</i>

8 Screen: Manufacturer *JOHNSON*
Type *GALVANIZE* Dia. *14"*
Slot gauze *100* Length *15*
Set between *60* ft. and *72* ft.
Fittings: Gravel pack Yes No Size range of material *3/4*

9 Static water level: *50* ft. below land surface Date ___

10 Pumping level below land surfaces:
65 ft. after *5* hrs. pumping *1000* g.p.m.
65 ft. after *10* hrs. pumping *1000* g.p.m.
Estimated maximum yield *1000* g.p.m.

11 Water sample submitted:
 Yes No Date ___

12 Well head completion: *74"*
 Pitless adapter Inches above grade

13 Well grouted? Yes No
 Neat cement Bentonite
Depth: From *0* ft. to *10* ft.

14 Nearest source of possible contamination: *None*
ft. ___ Direction ___ Type ___
Well disinfected upon completion? Yes No

15 Pump: *Yes* Not installed
Manufacturer's name *Z.S. Pump Co.*
Model number *137533* HP *150* Volts ___
Length of drop pipe *90* ft. capacity *1000* g.p.m.
Type: Submersible Turbine
 Jet Reciprocating
 Centrifugal Other

16 Remarks: elevation

CONCRETE SLAB TO BE INSTALLED BY HAND OWNER 24" ABOVE GROUND

Arden Dillinger by James Dillinger

Topography:
 Hill
 Slope
 Upland
 Valley

17 Water well contractor's certification:
This well was drilled under my jurisdiction and this report is true to the best of my knowledge and belief.

Ralph's Irrigation Drilling & Contr
Business name License No. *154*
Address *1300 So. MAIN*
Signed *Ralph E. Woods* Date *4-26-76*
Authorized representative

Springfield, Colo. 81073
Form WWCS-5

3043W29NWSESE